


Section 5 Township 34 Range 3E

Well No. #2 Collinson "B"

Company McNeish & Grallop

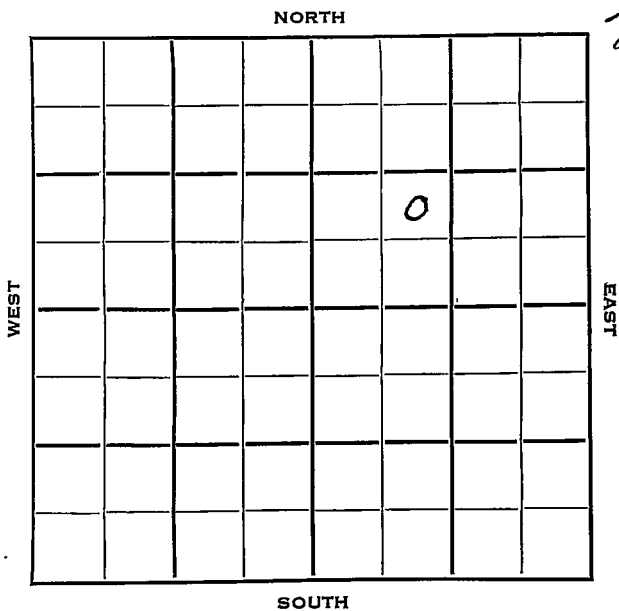

Sec. 5 Twp. 34 R. 3E

Well No. #2 Collinson "B" Farm

McNeish & Grallop Company

McNeish & Grallop Contractor

Gueda Springs Pool


Ft. from N. Line

990 Ft. from S. Line

Ft. from E. Line

990 Ft. from W. Line

NE SW NE

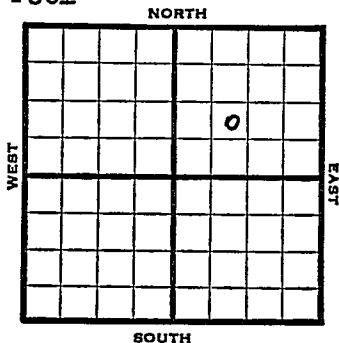

1953 Elev. 1097' REPORT

5/6 Location

6/24 Spud 5-17-53
 Oil Well
 TD 3312
 8" @ 90
 Bart 3299
 5" @ 3306
 CO to 3312, PB 3311, sd-frac
 Comp. 25 bopd 3 bw

COMPLETED

