


Map No. Can Sec. 3 Twp. 34 R. 3

Well No. 1 Martin Farm

Super oil Company

NORTH

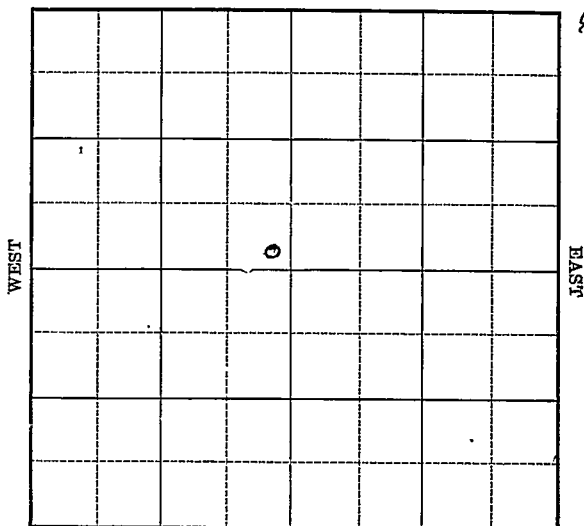

SOUTH

Location _____

Drilling Remarks

Rig Up_____

Drilling Remarks

RECORD

Cased_____in. _____ft.

Sand

Gas

Oil

Total Depth _____

PRODUCTION

1st 24 hrs. Nat. _____

1st 24 hrs. after shot -----

Gas_____cu. ft.

Dry Hole

Abandoned

Map No. Kanawha Sec. 5 Twp. 34 R. 3E

Well No. 1 Martin Farm


Gypsy Oil. Company

Ft. from N. Line

300 Ft. from S. Line

300 Ft. from E. Line

-----Ft. from W. Line

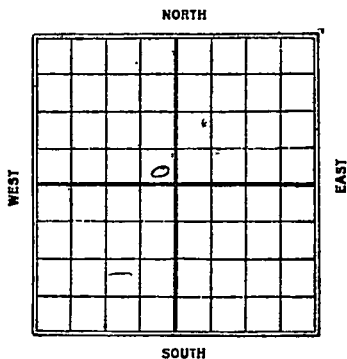[illegible]

K1 *Cowley*
 Map No. **KANSAS** Sec. *5* Twp. *34* R. *3E*

Well No. *1 Martin*

Gypsy Oil Company

Contractor

SECTION PLAT

_____ Ft. from N. Line

300 Ft. from S. Line

300 Ft. from E. Line

_____ Ft. from W. Line

FIRST REPORTS

Location _____

Rig up _____

Drilling and Remarks:

ROY.

RECORD

Cased: _____ in., _____ ft.

Sand _____

Gas _____

Oil _____

Total Depth _____

PRODUCTION

1st 24 hrs. Nat. _____

1st 24 hrs. after shot _____

Gas _____ Cu. Ft.

Dry Hole _____

Abandoned _____

Date

MAR 3 1926 *S. J. LEWIS* Scout

Country *Kansas*
 Map No. *K1* **KANSAS** Sec. *5* Twp. *34* R. *3E*

Well No. *1 Martin*

Sydney Oil Company

Contractor

SECTION PLAT

-----Ft. from N. Line

300 Ft. from S. Line

200 Ft. from E. Line

-----Ft. from W. Line

COMPLETED

Location -----

Rig up -----

Drilling and Remarks:

Top Chas. 3322.

TII 3345

Pumped 6048

37 1/2 Gr.

RECORD

Cased ----- in., ----- ft.

Sand -----

Gas -----

Oil -----

Total Depth -----

PRODUCTION

1st 24 hrs. Nat. -----

1st 24 hrs. after shot -----

Gas ----- Cu. Ft.

Dry Hole -----

Abandoned -----

Date

JUN 2 1926

S. J. LEWIS

Scout