


Ellis

KANSAS

SECTION 36 TOWNSHIP 14S RANGE 19W

WELL NO. #1 Befort "A"

COMPANY Frontier & Rains & Williamson

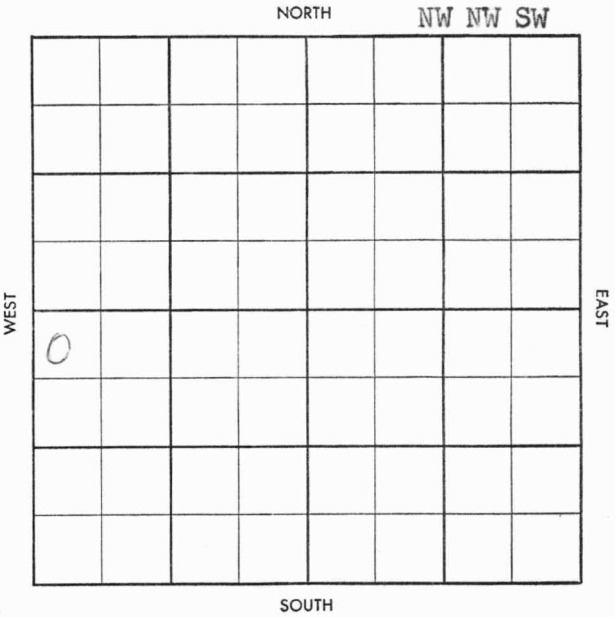

Twp. Pool


Co. Facet

5-513-B

County Ellis Elev. 2084 OF 2087 RB
 Sec. 36 Twp. 14 Rge. 19W
 Company Frontier & Rains & Williamson
 Farm Name Befort "A" No. 1

TOPS	DEPTH	LOG	DATUM
Anh.	1315		
Tp.			
H.	3344		
Tr.			
Dg.			
B.L.			
L.	3394		
K.C.			
B.K.C.	3632		
Ce. <u>MAR 44</u>	3635		
C.			
M.			
M.			
K.			
Mz.			
Mq.			
V.			
S.			
S.			
A.	3689		
R.			
Pf.			
G.			
T.D.	3712		

Loc. in Sec. NW NW SW
 Geol. _____
 Contr. _____
Red Tiger
 Pool _____
Antonion Trst

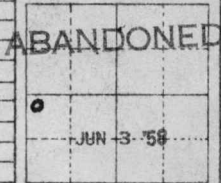

Date Comm. 5-20-58 (Phillips Ac) (Texas - DHM)

MIRT MAY 28 58 8" 204/135 DST 3411-24

2 hrs 915' SW BHP 1300/30" FP

200-620 3471 JUN 3-58 DST 3666-72

op 30" 30' M SPR soil all P zero

DST 3689 - ~~3689~~ 93 op 30"

4' M NS BHP normal DST 3690

- 97 op 2 hrs 700' free oil 1100' W

FP 620-1010 BHP 1260/20" log

D+A

~~Phillips Ac~~ ~~Pool~~
~~Co.~~ ~~Page 14~~

S-513-B

County Ellis Elev. _____
 Sec. 36 Twp. 14 Rge. 19W
 Company Frontier & Rains & Williamson
 Farm Name Befort "A" No. 1

TOPS	DEPTH	LOG	DATUM
Anh.			
Tp.			
H.			
Tr.			
Dg.			
B.L.			
L.			
K.C.			
B.K.C.			
Ce.			
C.			
M.			
M.			
K.			
Mz.			
Mq.			
V.			
S.			
S.			
A.			
R.			
Pf.			
G.			
T.D.			

Loc. in Sec. _____
NW NW SW
 Geol. _____
 Contr. _____
Red Tiger
 Pool _____
Antonion Twinst



Date Comm. (Phillips Ac)(Texas - DHM)
MIRT

Co.
Lse.
No.
Sec.
T.
R.