


Section 5 Township 34 Range 3-E

Well No. #2 Martin

Company Laura Jane Oil

NORTH

*M*

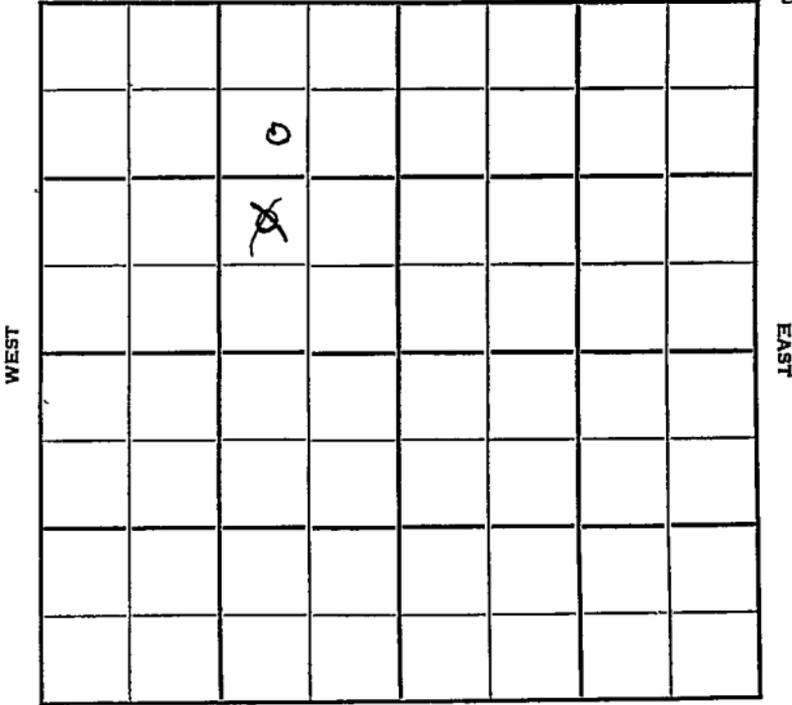

SOUTH

WEST

EAST

Sec. 5 Twp. 34 R. 3E

Well No. #2 Martin Farm

Laura Jane Oil Company


Gueda Springs Pool Contractor

990 Ft. from N. Line

990' Ft. from S. Line

990' 825- Ft. from E. Line

\_\_\_\_\_ Ft. from W. Line

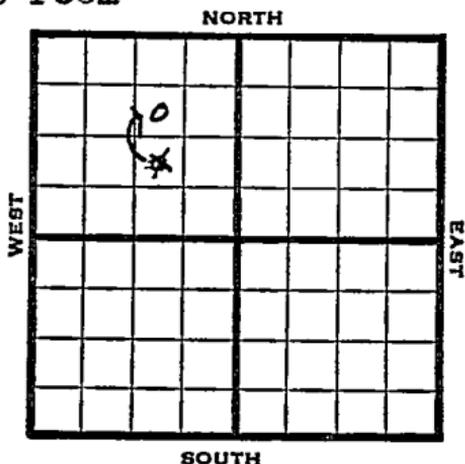

~~NW SE NW~~

C S L S W N E N W

1950 Elev 1094' REPORT

12/27 Spud 12-26-50

1951

1/24

Spud 12-26-50

8" @ 92

Chat 3317-19

4 1/2" @ 3317

FU 2000' oil F/37 bopd F/10 bopd

TD 3335

Comp 35 bopd

Completed

**COMPLETED**

County Cowley State Kansas

Sec. 5 (Blk.) 34 (Sur.) 3E Map No.

Operator Laura Jane Oil

Well No. 2 Farm Martin

Elev. 1094 Location C S L SW NE NW


990 Ft. From N Line NW

825 Ft. From E Line Quarter

Ist. Report

Completion JAN 24 1951

Remarks Gueda Springs Pool

Spudding Date 12-26-50

Drlg: Data Oil well TD 3335

8" @ 92 Chat 3317-19 4 1/2" @ 3317

FU 2000' oil F/ 37 bopd F/ 10 bopd

TD 3335 Comp. 35 bopd

J. E. TYRA

Map No. \_\_\_\_\_ Sec. 5 Twp. 34 R. 3EWell No. 2 MartinLaura Jane Oil CompanyCORRECTION Contractor

C S L SW NE NW

## SECTION PLAT

990 Ft. from N. Line

	o		

\_\_\_\_\_ Ft. from S. Line

825 Ft. from E. Line

\_\_\_\_\_ Ft. from W. Line

Cowley County

Location \_\_\_\_\_

## RECORD

Cased \_\_\_\_\_ in., \_\_\_\_\_ ft.

Rig up \_\_\_\_\_

Sand \_\_\_\_\_

Drilling and Remarks:

Gas \_\_\_\_\_

Oil \_\_\_\_\_

Reported \_\_\_\_\_

Total Depth \_\_\_\_\_

NW SE NW

## PRODUCTION

1st 24 hrs. Nat. \_\_\_\_\_

1st 24 hrs. after shot \_\_\_\_\_

Gas \_\_\_\_\_ Cu. Ft.

Dry Hole \_\_\_\_\_

Abandoned \_\_\_\_\_

Date

JAN 24 1919J. E. TYRA

Scout

County Cowley State Kansas

Sec. 5 (Blk. 34 (Sur. 3E (Twp.) (Rge.) Map No.

Operator Laura Jane Oil

Well No. 2 Farm Martin

Elev. Location NW SE NW

	0		

990 Ft. From S Line NW

990 Ft. From E Line Quarter

Ist. Report DEC 27 1950

Completion \_\_\_\_\_

Remarks \_\_\_\_\_

Spudding Date 12-26-50

Drlg. Data Gueda Springs Pool