

Section 32 Township 13 Range 19W

Well No. #5 Gus Riedel

Company Texas Co.

NORTH

6							

13

WEST

EAST

SOUTH

Sec. 32 Twp. 13 R. 19W

Well No. #5 Gus Riedel Farm \_\_\_\_\_

Texas Co. Company \_\_\_\_\_

Wakefield Contractor \_\_\_\_\_


\_\_\_\_\_ Ft. from N. Line

330 Ft. from S. Line

\_\_\_\_\_ Ft. from E. Line

330 Ft. from W. Line

SW SW SW

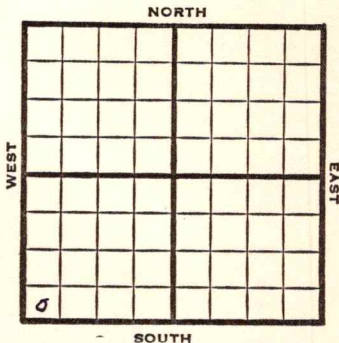

1952

Elev. 2275'

REPORT

3/26

Spud 3-24-52  
Drlg. 475'

4/2

8" @ 647'  
Drlg. 3160'

4/9

DST 3588-3603, 1 hr. 1350 SW  
1245# 5" @ 3892' WOC

4/23

Anhy 1558' Topeka 3264' Lans 3516'  
Cong. 3863' Arb. 3888'  
TD 3894' CO to 3894' S/3 BOPH  
for 8 hrs. DD to 3900 S/8 BOPH  
for 8 hrs. DD to 3905' TD  
S/10½ BOPH for 3 hrs. 500 A  
S/30 BOPH POP

4/30

NR

5/7

"

5/14

"

5/21

"

5/28

"

6/11

Spud 3-24-52  
Oil well TD 3905' 8" @ 647  
DST 3588-3603 open 1 hr, rec 1350' SW  
5" @ 3892 Anhy 1558' Top. 3264'  
Lans. 3516' Cong. 3863' Arb. 3888'  
TD 3894' 5" @ 3892' CO to 3894'  
S/3 BOPH DD 3900' S/8 BOPH  
DD 3905' S/10½ BOPH 500 A  
S/30 BOPH Comp. 352 BOPD

COMPLETED



