


Section 5 Township 34 Range 3E

Well No. #3 Martin

Company Laura Jane

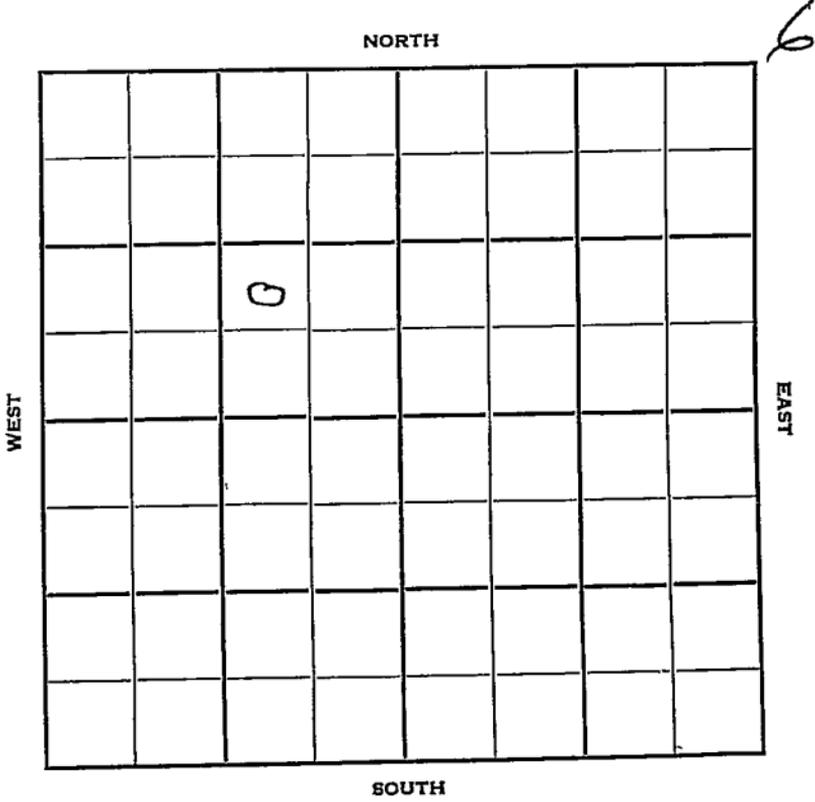

Cowley

KANSAS ✓

Sec. 5 Twp. 34 R. 3E

Well No. #3 Martin Farm

Laura Jane Company

Laura Jane Contractor

_____ Ft. from N. Line

990


_____ Ft. from S. Line

990

_____ Ft. from E. Line

_____ Ft. from W. Line

NW SE NW

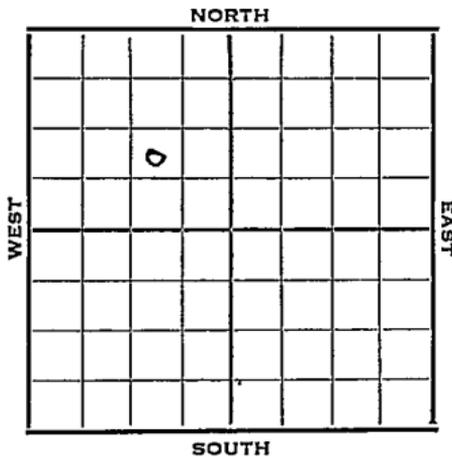


1952

Elev. 1092' REPORT

5/28 RU

7/9 Spud 5-27-52
 Oil Well TD 3334
 8" @ 80
 Chat 3316 TD 3320
 5" @ 3320 DD 3334
 SO&W PB 3327
 S/1 boph 5 hr. Comp. 20 bopd

COMPLETED

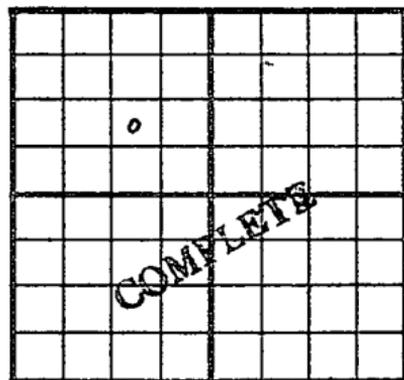County Cowley State KansasSec. 5 (Blk. Twp.) 34 (Sur. Rge.) 3E Map No.Operator Laura JaneWell No. 3 Farm MartinElev. 1092 Location NW SE NW990 Ft. From S Line NW990 Ft. From E Line Quarter

1st. Report

Completion JUL 9 1952

Remarks

Laura Jane - Contr.Spudding Date 5-27-52Drlg. Data Oil well TD 33348" @ 80 Chat 3316 TD 3320 5" @ 3320DD 3334 SO & W PB 3327 S/ 1 boph 5 hrComp. 20 bopd

J. G. McGEHEE