

Russell


KANSAS

FORM 51

Section 21 Township 14 Range 13W

Well No. #1 A.C. Rogg "B"

Company United Drlg.

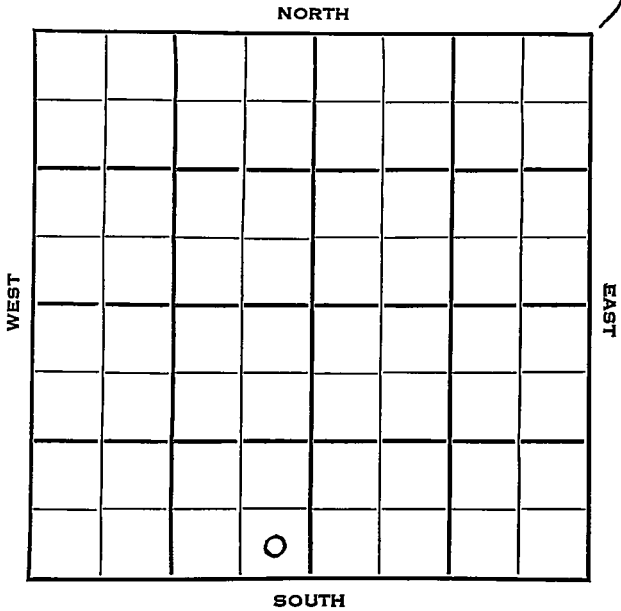

Russell

KANSAS

|      |      |      |
|------|------|------|
| SEC. | TWP. | R.   |
| 21   | 14   | 13 W |

WELL NO.

# 1 A. C. Rogg "B"

FARM

COMPANY

United Drlg.

CONTRACTOR

Hall-Burney Pool


Ft. from N. Line

330 Ft. from S. Line

330 Ft. from E. Line

Ft. from W. Line

SE SE SW

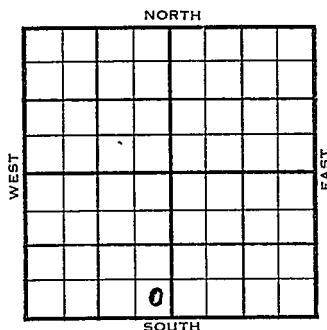

1954

ELEVATION

1760'

REPORT

1/6

Location

1/27

Oil well TD 2345 8" @ 167

Tarkio 2281 TD 2345 5" @ 2344

CO to 2325 24/2282-85 32/2303-07

B/1 BOPH B/2 GOPH

Comp. 25 BOPD

**COMPLETED**

County Russell State Kansas

Sec. **21** (Blk. Twp.) **14** (Sur. Rge.) **13W** Map No.

Operator **United Drig.**

Well No. 1 Farm A. C. Rogg "B"

Elev. 1760 Location SE SE SW

~~FIRST REPORT~~

330 Ft. From S Line SW

330 Ft. From E Line Quarter

1st. Report                      JAN      6   1954

### Completion

Remarks

Spudding Date

Drig. Data Hall-Gurney Pool

**Location**

J. G. McGEHEE

County Russell State Kansas

Sec. 21 (Blk. Twp.) 14 (Sur. Rge.) 13W Map No.

Operator      United Drlg.

Well No. 1 Farm A. C. Rogg "B"

|       |      |          |          |
|-------|------|----------|----------|
| Elev. | 1760 | Location | SE SE SW |
|-------|------|----------|----------|

[illegible]

330 Ft. From S Line SW

330 Ft. From H. Line Quarter

1st. Report

Completion JAN 27 1954

|         |                  |
|---------|------------------|
| Remarks | Hall-Gurney Pool |
|---------|------------------|

Spudding Date \_\_\_\_\_

Drlg. Data      Oil well      TD 2345

8" @ 167 Tarkio 2281 TD 2345

5" @ 2344 CO to 2325 24/ 2282-85

32/ 2 303-07    B/ 1 goph    B/ 2 goph

Comp. 25 bopd

**J. G. McGEHEE**