


Section 5 Township 34 Range 3 E

Well No. #3 Franklin Est.

Company Russell Cobb Jr. (Tulsa)

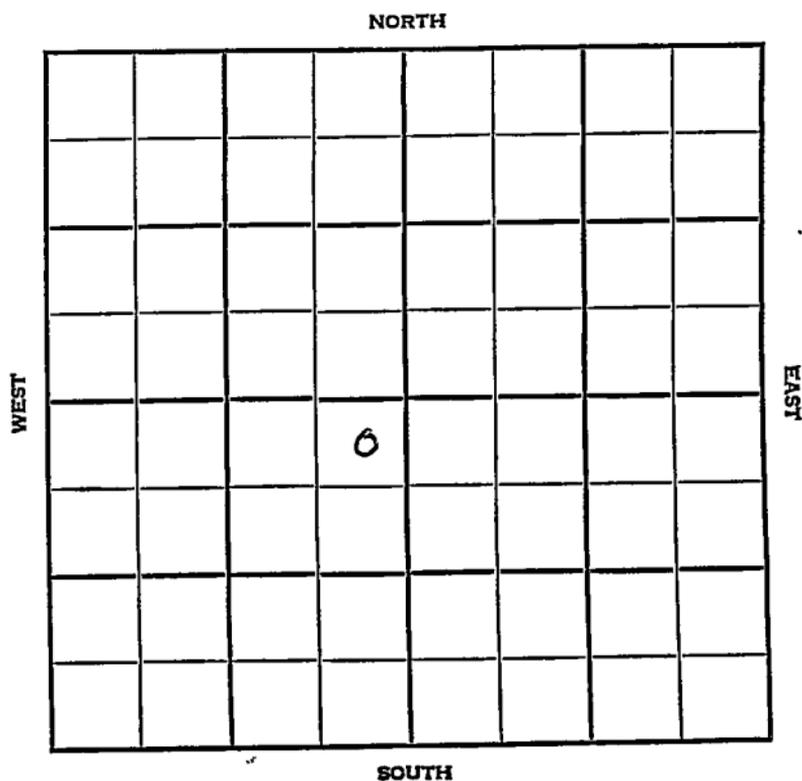

Cowley

KANSAS

SEC 5	TWP. 34	R. 3E
----------	------------	----------

WELL NO.

#3 Franklin Est.

FARM

COMPANY

Russell Cobb, Jr., (Tulsa)

CONTRACTOR

Harold Martin

Gueda Springs

NORTH

_____ Ft. from N. Line

_____ Ft. from S. Line

_____ Ft. from E. Line

_____ Ft. from W. Line

			0				

WEST

EAST

SOUTH

NE NE SW

1956	ELEVATION 1094'	REPORT
------	--------------------	--------

2-15 RUR for SWD

5-16 7" @ 2211 w/50
 CO to 2217
 CO 3418
 5" liner @ 3319
 Comp. for SWD well
 Stal. 2208
 Layton 2630
 KC. 2811
 Oswego 3060
 M. 3319
 TD 3418'

ABANDONED

County Cowley Elev. 1094
 Sec. 5 Twp. 34 Rge. 3E
 Company Russell Cobb Jr.
 Farm Name Franklin Est. No. 3

TOPS	DEPTH	LOG	DATUM
Anh. <u>Stal</u>	<u>2208</u>		
Tp. <u>Dayton</u>	<u>2630</u>		
H.			
Tr.			
Dg.			
Bl.			
L.			
K.C.	<u>2811</u>		<u>1717</u>
B.K.C. <u>Donner</u>	<u>3060</u>		<u>1966</u>
Ce.			
C.			
M.	<u>3319</u>		<u>2225</u>
M.			
K.			
Mz.			
Ma.			
V.			
S.			
S.			
A.			
R.			
Pe.			
G.			
TD.	<u>3418</u>		

Loc. in Sec. _____
NE NE SW
 Geol. _____
 Contr. _____
Harold Martin
 Pool _____
Gueda Spring

ABANDONED

	0	

Date Comm. MAY 16 1956

7" @ 2211/50 CO to 2217 CO 3418

5" liner @ 3319 Comp. for SWD well

Co.

No.

Sec.

T.

R.