
FORM 51 25M 8-50 WESTERN Trego KANSAS

Section 27 Township 14 Range 21 W

Well No. # 1 Colborg

Company Deep Rock

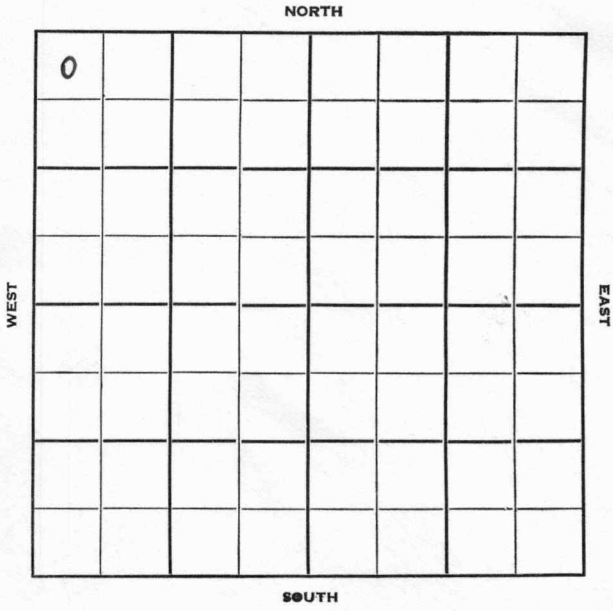

FORM 252-B
10M 8-51 TPCO.

Trego **HOT FILE** KANSAS

Sec. 27 Twp. 14 R. 21W

Well No. #1 Colborg Farm

Deep Rock Company


Creekmore Contractor

330 Ft. from N. Line

Ft. from S. Line

Ft. from E. Line

330 Ft. from W. Line

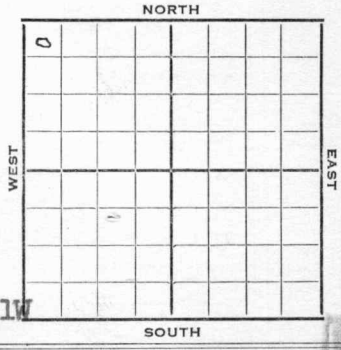

NW NW NW
MCPC has W/2 of 35-14-21W

1952	Elev. 2092' REPORT
6/18	Location
6/25	10" @ 250' Drlg 2392'
7/2	Heeb. 3376 Tor. 3404 Lans. KC 3414 Drlg. 3535'
7/9	BKC 3663 Marm 3750 DST 3751-3770 1/2 hr. 8' SOCM 740# Arb. 3836 DST 3832-51 1 hr. 280' HOCM 1110# DST 3851-84 3/4 hr. 400' OCM 360' muddy oil 450' oil & W 1290 OCSW 1060# Schl RTD 3890 7" @ 3890
7/17	CO 3861 10/3858-60 fill up 90' fluid 1 hr. 9/3857-58½ fill up 150' fluid 2 hrs. 10% wtr 24/3852-57 fill up 350 fluid 3 hrs. 9/3850-52 600' fluid 4 hrs. 10% wtr S/6½ BFPH 10% wtr 500 A S/9 BO & 15 BWPH Sq off
7/23	36/ 3638-44 S/ 1½ galfph 500 A S/ 69 BO & 149 BW 6 hrs. sq. off 30/3822-37 S/ 190 BO 12 hrs.
7/30	Basal Penn 3822'

OVER

1952
8/6 Spud 6-19-52
Oil well TD 3890' 10" @ 250
Heeb 3376' Tor. 3394' Lans. 3414'
B KC 3663' Marm. 3750'
DST 3751-3770 open ½ hr. rec 8' SOCM
740# Arb. 3836'
DST 3832-51 open 1 hr. rec 280' HOCM
1110#
DST 3851-84 open 3/4 hr. rec 400' OCM
360' muddy oil, 450' oil & water
1290' OCSW 1060# TD 3890'
7" @ 3890 CO to 3861 10/3858-60
FU 90' fluid 1 hr. 9/3857-58
FU 150' fluid 2 hr. 10% water
24/3852-57 FU 350' fluid 3 hr.
10% water
9/3850-52 FU 600' fluid 4 hr.
10% water S/6½ BFPH 10% water
500 A S/9 BO 15 BWPH 36/3638-44
S/1½ GFPH 500 A S/69 BO 149 BW
6 hr. 30/3822-37 S/190 BO 12 hr.
Basal Penn 3822'
Comp. 451 BOPD

COMPLETED

FORM 275 FOR SALE BY KANSAS BLUE PRINT CO.


County Trego State Kansas

Sec. 27 (Blk. Twp.) 14 (Sur. Rge.) 21W Map No.

Operator Deep Rock

Well No. 1 Farm Colborg

Elev. 2092 Location NW NW NW

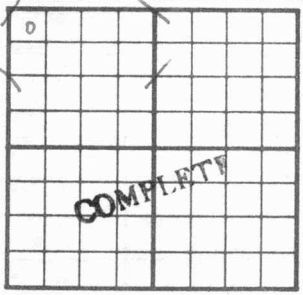

330 Ft. From N Line NW

330 Ft. From W Line Quarter

1st. Report

Completion AUG 6 1952

Remarks

Creekmore Drlg. - Contr.

Spudding Date 6-19-52

Drlg. Data Oil well TD 3890

10" @ 250 Heeb. 3376 Tor. 3394

Lans. 3414 B KC 3663 Marm. 3750

DST 3751-3770 open ½ hr. Rec. 8' socm

740# Arb. 3836 DST 3832-51 open 1 hr.

Rec. 280' hocm 1110# DST 3851-84

open 3/4 hr. Rec. 400' ocm 360' muddy

oil 450' oil & water 1290' ocsw 1060#

TD 3890 7" @ 3890 CO to 3861 10/ 3858-

60 FU 90' fluid 1 hr. 9/ 3857-58

FU 150' fluid 2 hr. 10% water 24/ 3852-

57 FU 350' fluid 3 hr. 9/ 3850-52

FU 600' fluid 4 hr. 10% water S/ 6½

bfph 10% water 500 A S/ 9 bo 15 bwph

36/ 3638-44 S/ 1½ gfph 500 A

J. G. McGEHEE

FORM 275 FOR SALE BY KANSAS BLUE PRINT CO.


County Trego State Kansas

Sec. 27 (Blk. Twp.) 14 (Sur. Rge.) 21W Map No.

Operator Deep Rock

Well No. 1 Farm Colborg

Elev. Location NW NW NW

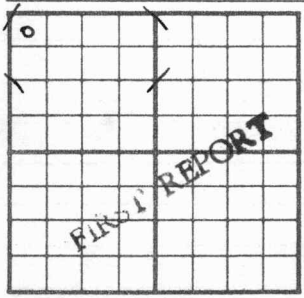

330 Ft. From N Line NW

330 Ft. From W Line Quarter

1st. Report JUN 18 1952

Completion

Remarks

Creekmore - Contr.

Spudding Date

Drlg. Data MCPC has W½ of 35-14-21W

Location

J. G. McGEHEE

Drlg. Data

S/ 69 bo 149 bw 6 hr. 30/ 3822-37

S/ 190 bo 12 hr. Basal Penn, 3822

Comp. 451 bopd

Scout Cards
Land Small Map
Land Wall Map
Tracings
Prince Map
Blueline Map
Misc.
AUG 11 1952