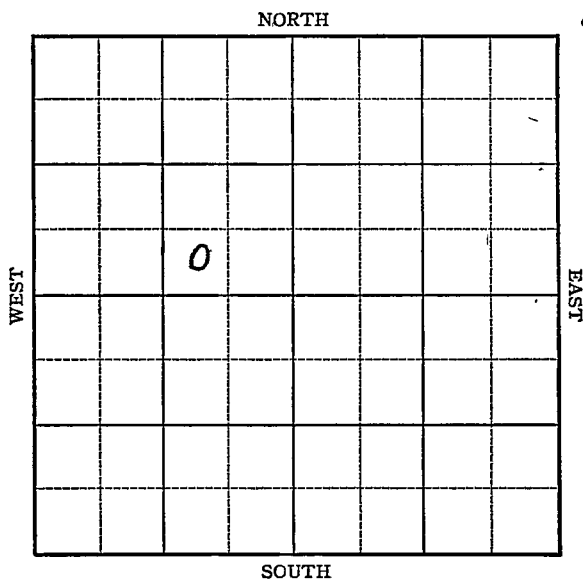


KANSAS

Cowley county

Section 5 Township 34 Range 3EWell No. #1, MartinCompany Dave Morgan Oil et al.

KANSAS

Cowley County

Sec. 5 Twp. 34 R. 3E

Well No. #1 Martin Farm

Dave Morgan Oil et al. Company

Miscellaneous


 Ft. from N. Line

330 Ft. from S. Line

990 Ft. from E. Line

 Ft. from W. Line

SW SE NW

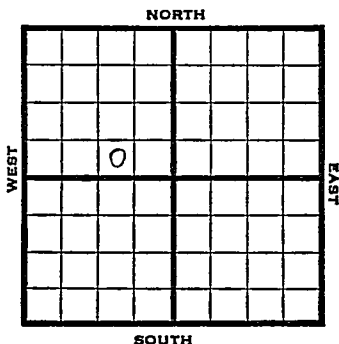

1946 Elev. 1094 REPORT

4/17 10" @ 114
Drlg. 900'

4/23 Chat 3324-26
TD 7" @ 3325 RUST

5/1 " " "

5/8 Chat 3324
7" @ 3325
TD 3351
Pump 30 oil plus 60 Wtr. Pot.
Grav. 36.0

COMPLETED

KANSASKansas Pool Name MiscellaneousMap No. 1 Sec. 5 Twp. 34 R. 3EWell No. 1 MartinDave Morgan Oil et al. Company**COMPLETED**

Contractor

SW SE NW

E1, 1094
SECTION PLAT

	2		

_____ Ft. from N. Line

330 Ft. from S. Line990 Ft. from E. Line

_____ Ft. from W. Line

Cowley County

Location _____

Rig up _____

Drilling and Remarks:

Chat 33247" @ 3325Run 30' oil + 60' Water
Pat36 1/2**RECORD**

Cased _____ in., _____ ft.

Sand _____

Gas _____

Oil _____

Total Depth 330**PRODUCTION**1st 24 hrs. Nat. 3324

1st 24 hrs. after shot _____

Gas _____ Cu. Ft.

Dry Hole _____

Abandoned _____

Date

MAY 8 1946S. J. LEWIS Scout