

Section 5 Township 34 Range 3-E

Well No. #3 Martin

Company Laura Jane
Miscellaneous

NORTH

6

WEST

EAST

			o				

SOUTH

Cowley

KANSAS ✓

Sec. 5 Twp. 34 R. 3E

Well No. #3 Martin Farm

Laura Jane Company

Contractor

Miscellaneous


 Ft. from N. Line

990' Ft. from S. Line

330' Ft. from E. Line

 Ft. from W. Line

NE SE NW

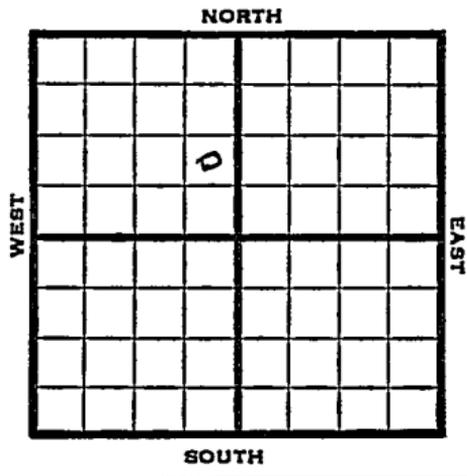

1950	Elev 1094' REPORT
3/1	Location
4/5	TD 3358'
	8"@ 90
	Miss 3317'
	5"@ 3317'
	15 BOPD
	Comp
	COMPLETED

Map No. _____ Sec. 5 Twp. 34 R. 3E

Well No. 3 Martin

Laura Jane _____ Company

Contractor _____

NE SE NW


SECTION PLAT

_____ Ft. from N. Line

990 Ft. from S. Line

330 Ft. from E. Line

_____ Ft. from W. Line

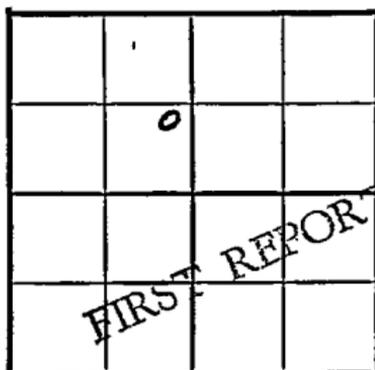

Cowley County

Location X

Rig up _____

Drilling and Remarks:

RECORD

Cased _____ in., _____ ft.

Sand _____

Gas _____

Oil _____

Total Depth _____

PRODUCTION

1st 24 hrs. Nat. _____

1st 24 hrs. after shot _____

Gas _____ Cu. Ft.

Dry Hole _____

Abandoned _____

Date

MAR 1 1950 19 _____

J. E. TYRA

Scout

Map No. _____ Sec. 5 Twp. 34 R. 3E

Well No. 3 Martin

Laura Jane Company

Contractor

NE SE NW

E. 1094
SECTION PLAT

_____ Ft. from N. Line

990 Ft. from S. Line

330 Ft. from E. Line

_____ Ft. from W. Line

COMPLETE			
0			

Cowley County

Location _____

Rig up _____

Drilling and Remarks:

8" @ 90

mine 3317

5" @ 3317

15 BOPD

RECORD

Cased _____ in., _____ ft.

Sand _____

Gas _____

Oil _____

Total Depth 3358

PRODUCTION

1st 24 hrs. Nat. _____

1st 24 hrs. after shot _____

Gas _____ Cu. Ft.

Dry Hole _____

Abandoned _____

Date APR 5 1950

J. E. TYRAS Scout