



Cowley

KANSAS

SEC.	TWP.	R.
5	34	3E ✓

WELL NO. \_\_\_\_\_

4 Morris FARM

COMPANY \_\_\_\_\_

McNeish & Gralapp


CONTRACTOR \_\_\_\_\_

330 \_\_\_\_\_ Ft. from N. Line

\_\_\_\_\_ Ft. from S. Line

990 \_\_\_\_\_ Ft. from E. Line

\_\_\_\_\_ Ft. from W. Line

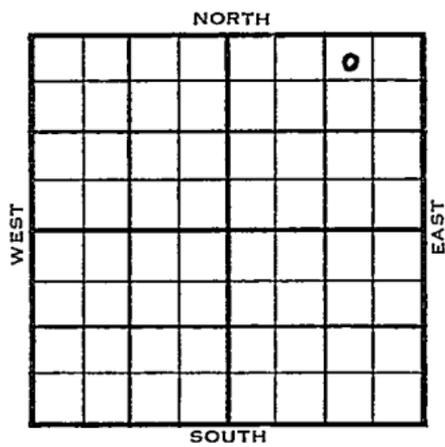

NW NE NE

	ELEVATION	REPORT
1953	1094'	

11/11 Drlg.

12/9 Spud 10-27-53

Oil Well

TD 3311'

8" @ 87'

Stal. 2216', Layton 2634', KC 2800',

Oswego 2990', Bart 3301'

TD 3311'

5" @ 3301'

CO to 3311'

sd-oil-frac

Comp. 25 bopd

COMPLETED

County **Cowley** State **Kansas**

Sec. **5** (Blk. Twp.) **34** (Sur. Rge.) **3E** Map No.

Operator **McNeish & Gralapp**

Well No. **4** Farm **Morris**

Elev. **1094** Location **NW NE NE**


**330** Ft. From **N** Line **NE**

**990** Ft. From **E** Line **Quarter**

Ist. Report **NOV 11 1953**

Completion

Remarks

Spudding Date

Drlg. Data

**drlg.**

**J. G. McGEHEE**

