


KANSAS

Section 2 Township 14 S Range 20 W

Well No. #2 Dreiling

Company SUNRAY

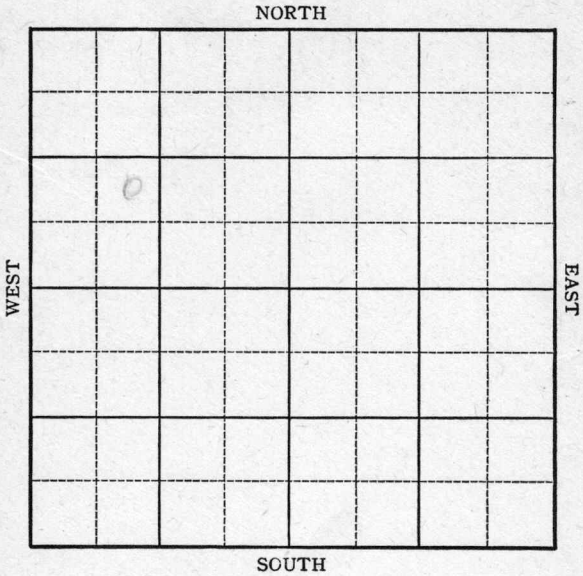

KANSAS Ellis County


Sec. 2 Twp. 14 R. 20W

Well No. #2 Dreiling Farm

Sunray Company

Pleasant

NORTH

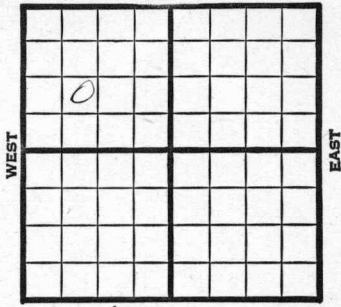

_____ Ft. from N. Line

990 Ft. from S. Line

_____ Ft. from E. Line

990 Ft. from W. Line

NE SW NW *Lev. 2276* SOUTH

REPORT

1945

4/11	Derrick	
4/20	"	
4/28	Drlg. 930'	
5/3	8" @ 1560	
	Drlg. 2630'	
5/10	3379' fsg.	
5/17	Heebner	3503
	Lans	3566
	Cong	3852
	Gorham	3873-3876
	TD 3876	
	5" @ 3873 RUST	
5/24	" " " " "	
5/29	Gorham	3873
	5" @ 3873	
	TD 3876	
	Pump 405 Pot.	
	Grav. 36.0	

COMPLETED

Kansas Pool Name Pleasant

Map No. 70 Sec. 2 Twp. 14 R. 20W

Well No. 2 Dreiling

Sunray Company

FIRST REPORT Contractor

NE SW NW

SECTION PLAT

o			

 Ft. from N. Line

990 Ft. from S. Line

 Ft. from E. Line

990 Ft. from W. Line

Ellis

Location

Rig up

Drilling and Remarks:

derrick

RECORD

Cased in., ft.

Sand

Gas

Oil

Total Depth

PRODUCTION

1st 24 hrs. Nat.

1st 24 hrs. after shot

Gas Cu. Ft.

Dry Hole

Abandoned

Date

APR 1 1 1945 19

S. J. LEWIS Scout

