


Section 2 Township 14 Range 20W

Well No. 3 Dreiling "B"

Company Sunray

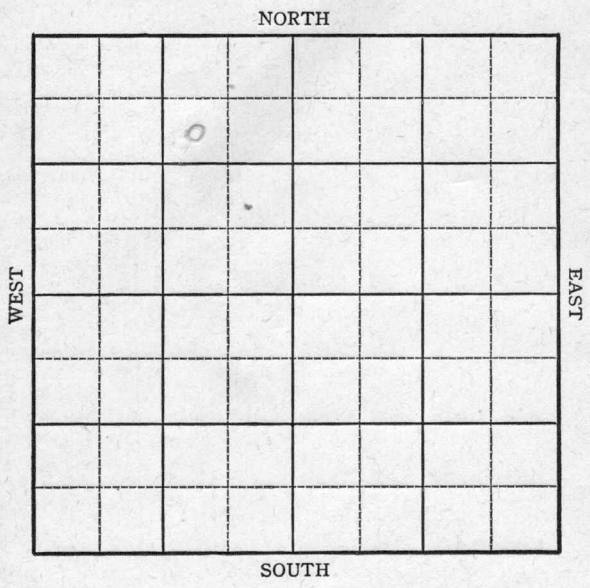

KANSAS

Ellis

Sec. 2 Twp. 14 R. 20W


Well No. 3 Drilling "B" Farm _____
Sunray Company _____

Orth 990 Ft. from N. Line

_____ Ft. from S. Line

990 Ft. from E. Line

_____ Ft. from W. Line

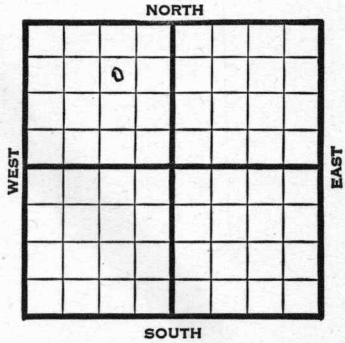

SW NE NW Elev. 2241

1945

REPORT

6/20
6/28
RUR
8" @ 1525
Drlg. 2755

7/3
7/11
Drlg. 3070
Heebner 3464
Lans 3528
Cong 3812
Gorham 3821
TD 3827
5" @ 3822 swb. 22 oil in 3 hrs.

7/19
7/26
TD 3835'
Pump 94 oil in 12 hrs.
" " " "

8/8
Gorham 3821
5 @ 3822'
T.D. 3825'
Pump 352 Pot
Gravity 42

COMPLETED

Kansas Pool Name Orth

Map No. 70 Sec. 2 Twp. 14 R. 20W

Well No. 3 Drilling "B"

Sunray Company

FIRST REPORT Contractor

SW NE NW

SECTION PLAT

990 Ft. from N. Line

Ft. from S. Line

990 Ft. from E. Line

Ft. from W. Line

	o		

Ellis County

Location _____

Rig up _____

Drilling and Remarks:

RUR

RECORD

Cased _____ in., _____ ft.

Sand _____

Gas _____

Oil _____

Total Depth _____

PRODUCTION

1st 24 hrs. Nat. _____

1st 24 hrs. after shot _____

Gas _____ Cu. Ft.

Dry Hole _____

Abandoned _____

Date

JUN 20 1945 19

S. J. LEWIS Scout

KANSAS Kansas

Pool Name Orth

Map No. 70 Sec. 2 Twp. 14 R. 20W

Well No. 3 Dreiling "B"

Sunray Company

COMPLETE

Contractor

SW NE NW

E 12241

SECTION PLAT

990 Ft. from N. Line

_____ Ft. from S. Line

990 Ft. from E. Line

_____ Ft. from W. Line

	0		

Ellis County

Location _____

Rig up _____

Drilling and Remarks:

Goekam 3821
5' @ 3822
Pump 352 Pt.

42° Gr

RECORD

Cased _____ in., _____ ft.

Sand _____

Gas _____

Oil _____

Total Depth 3825

PRODUCTION

1st 24 hrs. Nat. _____

1st 24 hrs. after shot _____

Gas _____ Cu. Ft.

Dry Hole _____

Abandoned _____

Date

AUG 8 1945 19

S. J. LEWIS Scout