


Ellis

Section 32 Township 13 **KANSAS** Range 19W

Well No. #13 Reidel

Company Texas Company

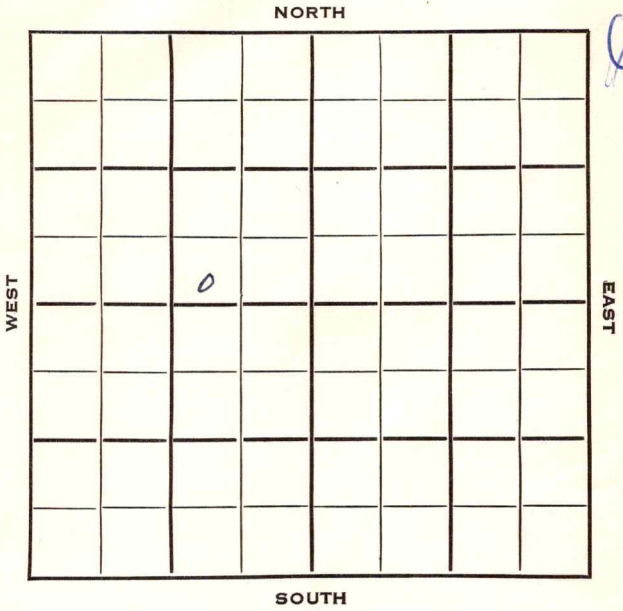

Ellis
13

KANSAS
19W

Sec. 32 Twp. _____ R. _____

Well No. #13 Reidel Farm _____

Texas Company Company _____

Contractor _____


_____ Ft. from N. Line

330 Ft. from S. Line

990 Ft. from E. Line

_____ Ft. from W. Line

SW SE NW

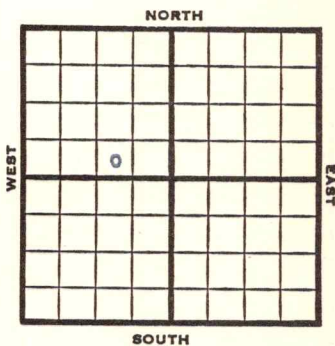

1953 Elev. 2244' REPORT

1/28 Spud 1-26-53
10" @ 278

2/5 Drlg. 3148'

2/12 Heeb 3504' Lans. 3549' Arb. 3894'
TD 3899' 7" @ 3889

2/19 NR

2/26 CO 3899 5 GWPH plus SSO 500 A
S/6½ BWPH plus SSO

3/12 "

3/18 Spud 1-26-53
D&A
TD 3901
10" @ 278
Heeb 3504, Lans 3549, Arb. 3894
TD 3899
7" @ 3889
CO to 3899
5 gwph & SSO, 500A
S/6½ bwph & S SO, DD 3901
41/3888-3901, PB 3896
sd-frac B/3½ go 5½ gwph 6 hrs.
1500A S/156 bw 3 hrs.
D&A

ABANDONED

