


Section 33 Township 13 Range 19 W

Well No. # 1 ^{Bemis} ~~Beaman~~

Company Rine Drlg. et al

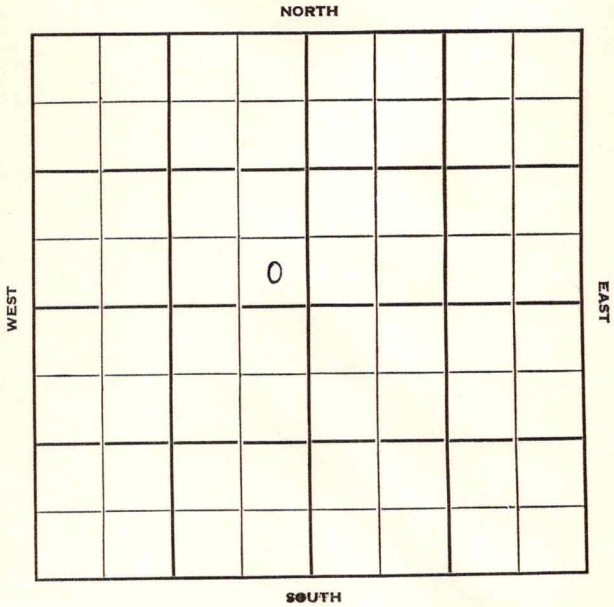

Ellis

KANSAS

Sec. 33 Twp. 13 R. 19W

Well No. #1 ^{Bemis} ~~Beaman~~ Farm

Rine Drlg. et al Company

Semi-Wildcat Contractor


 Ft. from N. Line

330' Ft. from S. Line

330' Ft. from E. Line

 Ft. from W. Line

SE SE W

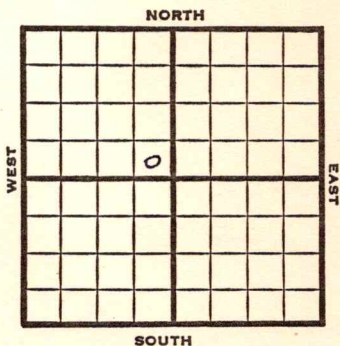

1951

REPORT

Elev. 2240'

7/11

Location

8/1

Spud 7-16-51 D & A TD 3976'
8" @ 214 Top. 3267' Heeb 3530'
Lans. 3576'

DST 3588-3611 open 1 hr. rec 40' mud & SSO

DST 3688-3716 open 1/2 hr. rec 10' mud

DST 3721-58 open 1 hr. rec 60' mud & water. B KC 3822' Cong 3879'

Arb. 3935-76' TD

D & A

ABANDONED

County Ellis State Kansas

Sec. 33 (Blk. 13 (Sur. 19W (Twp.) 13 (Rge.) 19W Map No.

Operator Rine Drlg. etal.

Well No. 1 Farm Beaman Bemis

Elev. 2240 Location SE SE NW

330 Ft. From S Line NW

330 Ft. From E Line Quarter

Ist. Report

Completion AUG 1 1951

Remarks Semi Wildcat

Spudding Date 7-16-51

Drlg. Data D & A TD 3976

8" @ 214 Top. 3267 Heeb. 3530

Lans. 3576 DST 3588-3611 open 1 hr.

Rec. 40' mud & SSO DST 3688-3716

open 1/2 hr. Rec. 10' mud DST 3721-58

open 1 hr. Rec. 60' mud & water B KC 3822

Cong. 3879 Arb. 3935-76 TD

D & A