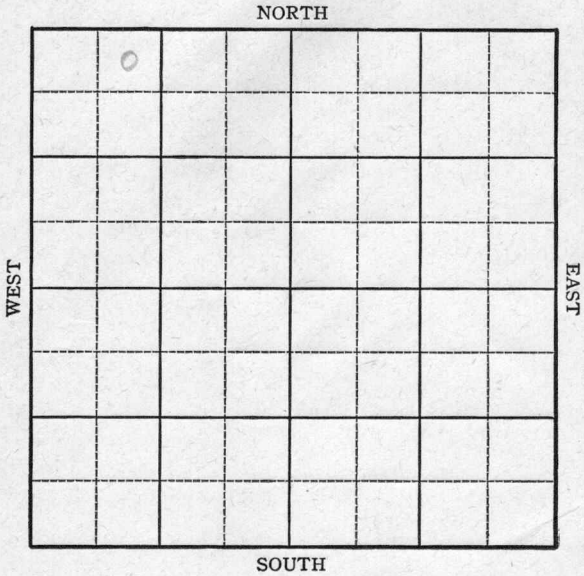


Section 2 Township 14 Range 20WWell No. 4 Dreiling "B"Company Sunray

KANSAS Ellis

Sec. 2 Twp. 14 R. 20-W


Well No. #4 Dreiling "B" Farm
Sunray Company

330 Ft. from N. Line

Ft. from S. Line

Ft. from E. Line

990 Ft. from W. Line

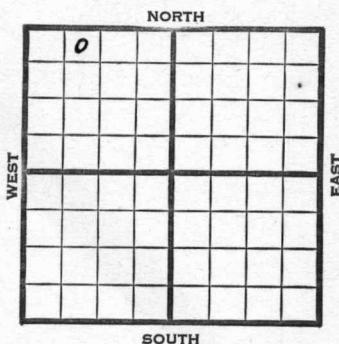

NE NW NW Elev. 2203

1945

REPORT

8/8	Location
8/15	Drlg. 1475
8/22	Anhy 1520
	8" @ 1518
	Drlg. 3270'
8/29	Arb. 3824-3827
	TD 3827
	5" @ 3825 RUST
9/5	TD 3832 swb. $7\frac{1}{2}$ oil per hr. 6 hrs.
	No wtr.
9/12	Lans 3528
	BKC 3751
	Cong 3818
	TD 3832'
9.19	" " "
9/26	No report
10/3	Arb. 3824
	5" @ 3825
	TD 3832'
	Pump 219 Pot.
	Grav. 33.0

COMPLETED

KANSAS

Pool Name OrthMap No. 70 Sec. 2 Twp. 14 R. 20WWell No. 4 Dreiling "B"Sunray

Company

FIRST REPORT

Contractor

NE NW NW

SECTION PLAT

0			

330 Ft. from N. Line Ft. from S. Line Ft. from E. Line990 Ft. from W. LineEllis CountyLocation XRig up

Drilling and Remarks:

RECORD

Cased in., ft.Sand Gas Oil Total Depth

PRODUCTION

1st 24 hrs. Nat. 1st 24 hrs. after shot Gas Cu. Ft.Dry Hole Abandoned

Date

AUG 8 1945

19

S. J. LEWIS Scout

KANSAS ~~Kansas~~ Pool Name OrthMap No. 70 Sec. 2 Twp. 14 R. 20WWell No. 4 Dreiling "B"Sunray

Company

COMPLETED

Contractor

NE NW NWE1. 2235

SECTION PLAT

<u>0</u>			

330 Ft. from N. Line Ft. from S. Line Ft. from E. Line990 Ft. from W. LineEllis CountyLocation Rig up

Drilling and Remarks:

Cor 838245" C 3825.Pump 219 St.330 Gr

RECORD

Cased in., ft.Sand Gas Oil Total Depth 3832

PRODUCTION

1st 24 hrs. Nat. 1st 24 hrs. after shot Gas Cu. Ft.Dry Hole Abandoned

Date

OCT 3 1945 19S. J. LEWIS

Scout