


DX 78-1 Ellis

KANSAS

Section 33 Township 13 Range 19W

Well No. #1 Bemus

Company Aiken & Owens

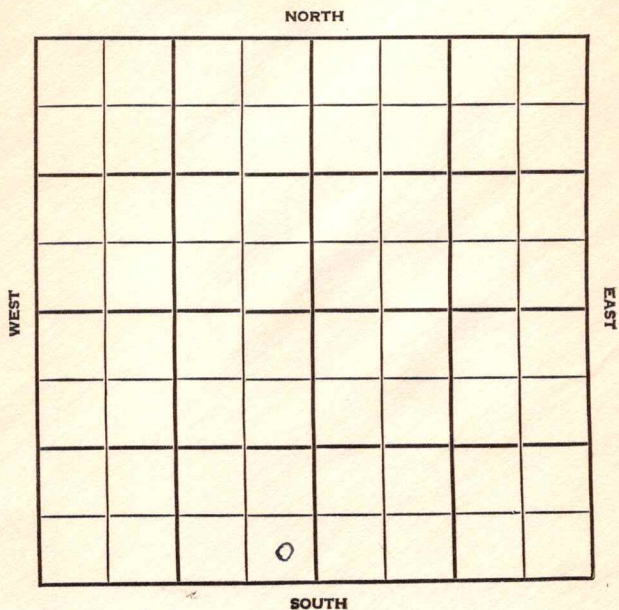

Ellis KANSAS


SEC.	TWP.	R.
33	13	19W
WELL NO.		
1 Bemus		FARM
COMPANY		

Aiken & Owens

CONTRACTOR

Thunderbird
Semi Wildcat

_____ Ft. from N. Line
 330 _____ Ft. from S. Line
 330 _____ Ft. from E. Line
 _____ Ft. from W. Line

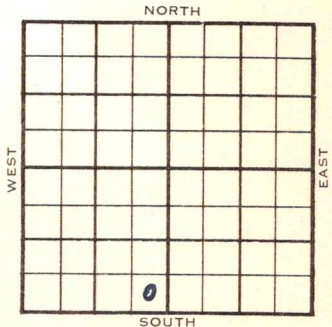

SE SE SW
Sunray FO

	ELEVATION	REPORT
1954	2229' KB - 2226'	DF
11/3	Spud 10-23-54 8" @ 223' Anhy 1525' Drlg. 3390'	
11/10	Spud 10-23-54 - D&A TD 3905' 8" @ 223' Anhy 1525', Heeb 3489', Tor 3511', Lans 3534' DST 3698-3718', opn 1 hr., rec. 10' mud, 0# Arb. 3855' DST 3856-62', opn 1 hr., rec. 20' mud, 0# DST 3865-70', opn 1/2 hrs., rec. 15' mud, 0# DST 3870-80', opn 1/2 hrs., rec. 20' mud, 570# TD 3905' D&A	

ABANDONED

County **Ellis** State **Kansas**

Sec. **33** (Blk.) **13** (Sur.) **19W** Map No.

Operator **Aiken & Owens**

Well No. **1** Farm **Bemus**

Elev. **2229** **2226** DF Location **SE SE SW**

FIRST REPORT

330 Ft. From **S** Line **SW**

330 Ft. From **E** Line Quarter

Ist. Report **NOV 3 1954**

Completion

Remarks **Sunray farmout**
Thunderbird - Contr.

Spudding Date **10-23-54**

Drlg. Data **Semi Wildcat**

8" @ 223 Anhy 1525 drlg. 3390

