


Section 2 Township 14 Range 20W

Well No. 1 Luea

Company Lewis Drlg.

NORTH

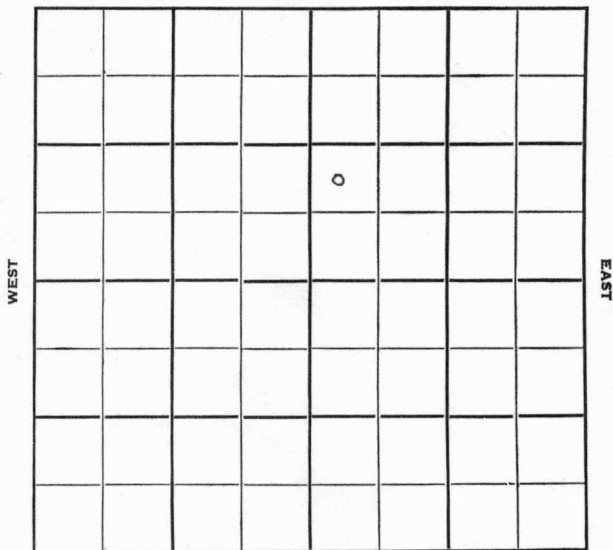

SOUTH

Ellis

KANSAS

Sec. 2 Twp. 14 R. 20 W

Well No. # 1 Luea Farm _____

Lewis Drlg. Company _____

Contractor _____


Pleasant Pool

_____ Ft. from N. Line

990 Ft. from S. Line

_____ Ft. from E. Line

330 Ft. from W. Line

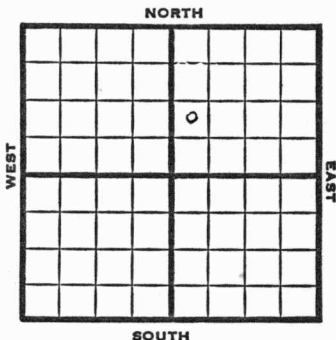

NW SW NE

1951

Elev. 2252'

REPORT

8/1 Spud 7-28-51
8" @ 212
Drlg. 885'

8/29 Spud 7-28-51
D&A TD 3895
8" @ 212
Heeb. 3505
KC 3557
Cong. 3853-95 TD
D&A

ABANDONED

County Ellis State Kansas

Sec. 2 (Blk. 14) (Sur. 20W) (Twp.) (Rge.) Map No.

Operator Lewis Drlg.

Well No. 1 Farm Luea

Elev. 2252 Location NW SW NE

990 Ft. From S Line NE

330 Ft. From W Line Quarter

1st. Report AUG 1 1951

Completion _____

Remarks _____

Spudding Date 7-28-51

Drlg. Data Pleasant Pool

8" @ 212 drlg. 885

J. E. TYRA

County Ellis State Kansas

Sec. 2 (Blk. 14) (Sur. Rge.) 20W Map No.

Operator Lewis Drlg.

Well No. 1 Farm Luea

Elev. 2252 Location NW SW NE

			0		

990 Ft. From S Line NE

330 Ft. From W Line Quarter

1st. Report

Completion AUG 29 1951

Remarks Pleasant Pool

Spudding Date 7-28-51

Drlg. Data D & A TD 3895

8" @ 212 Heeb. 3505 KC 3557

Cong. 3853-95 TD

D & A

J. E. TYRA