


Section 5 Township 34 Range 3 E

Well No. # 2 Morris "B"

Company Gralapp & McNeish

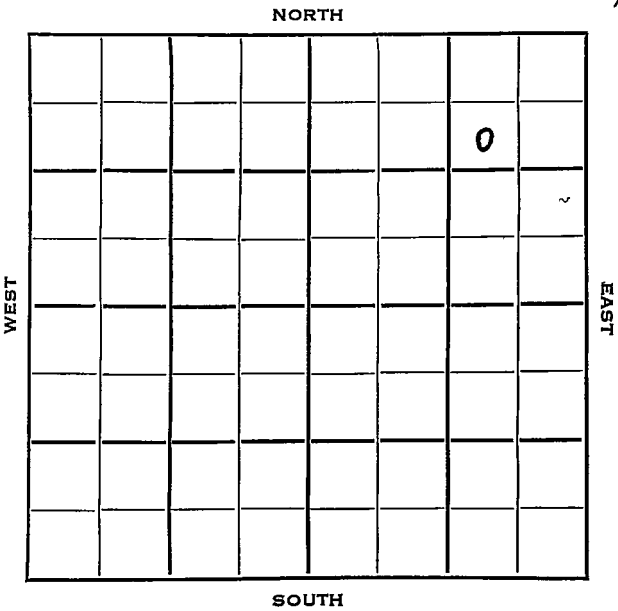

Sec. 5 Twp. 34 R. 3 E

Well No. # 2 Morris "B" Farm

Gralapp & McNeish Company

Contractor


Gueda Springs Pool

990 Ft. from N. Line

 Ft. from S. Line

990 Ft. from E. Line

 Ft. from W. Line

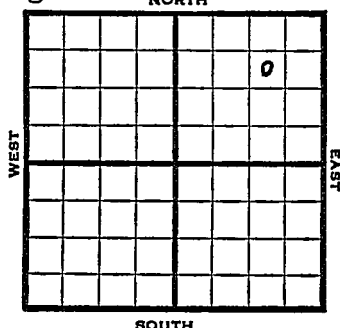

1953 Elev. 1106' REPORT

5/13 Spud 5-8-53
8" @ 94
Drlg. 2025'

6/10 Spud 5-8-53 Oil well TD 3331
8" @ 94 KC 2972 Bart 3288
Miss 3321 TD 3331 5" @ 3300
CO to 3325 PB 3323 Hydro
Comp. 35 BOPD

COMPLETED

J. G. McGEHEE

J. G. McGEHEE