


Sec. 2 Twp. 14 R. 20-W

Well No. #4 Orth Farm _____
Sunray Oil Company _____

_____ Ft. from N. Line
330 Ft. from S. Line
990 Ft. from E. Line
_____ Ft. from W. Line

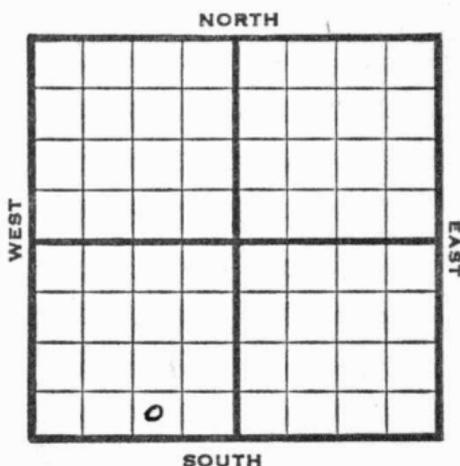

SW SE SW

1945 Elev. 2238 REPORT

10/10 Drlg. 107'
10/17 Anhy. 1521
8" @ 1527
Drlg. 2770'
10/24 Lans 3558
BKC 3751
Cong. 3824
Gorham 3829
TD 3854
5" @ 3850 RUST
10/31 Swab 75 oil in 5 hrs.
11/7 " " " "
11/14 " " " "
11/21 " " " "
11/28 " " " "
12/5 " " " "
12/12 Gorham 3829
5" @ 3850
TD 3854
Pump 308 Pot.
Grav. 31.0

COMPLETED

Kansas Pool Name Pleasant
KANSAS

Map No. _____ Sec. 2 Twp. 14 R. 20W

Well No. 4 Orth

Sunray Oil Company

FIRST REPORT

Contractor _____

SW SE SW

SECTION PLAT

_____ Ft. from N. Line

330 Ft. from S. Line

_____ Ft. from E. Line

990 Ft. from W. Line

Ellis County

Location _____

Rig up _____

Drilling and Remarks:

107'

RECORD

Cased _____ in., _____ ft.

Sand _____

Gas _____

Oil _____

Total Depth _____

PRODUCTION

1st 24 hrs. Nat. _____

1st 24 hrs. after shot _____

Gas _____ Cu. Ft.

Dry Hole _____

Abandoned _____

Date

OCT 10 1945 19

S. J. LEWIS Scout

KANSAS Pool Name Pleasant

Map No. K-70 Sec. 2 Twp. 14 R. 20W

Well No. 4 Orth

Sunray Oil Company

COMPLETED

Contractor

E. 2238

SW SE SW

SECTION PLAT

_____ Ft. from N. Line

330 Ft. from S. Line

990 Ft. from E. Line

_____ Ft. from W. Line

Ellis County

Location _____

Rig up _____

Drilling and Remarks:

Gr. Ham 3829
5" C 3838
Pump 308 P.D.

310 G

RECORD

Cased _____ in., _____ ft.

Sand _____

Gas _____

Oil _____

Total Depth 3854

PRODUCTION

1st 24 hrs. Nat. _____

1st 24 hrs. after shot _____

Gas _____ Cu. Ft.

Dry Hole _____

Abandoned _____

Date

DEC 1 2 1945 19

S. J. LEWIS Scout