


Section 2 Township 14 Range 20 W

Well No. #2 Pfeifer "A"

Company Sunray

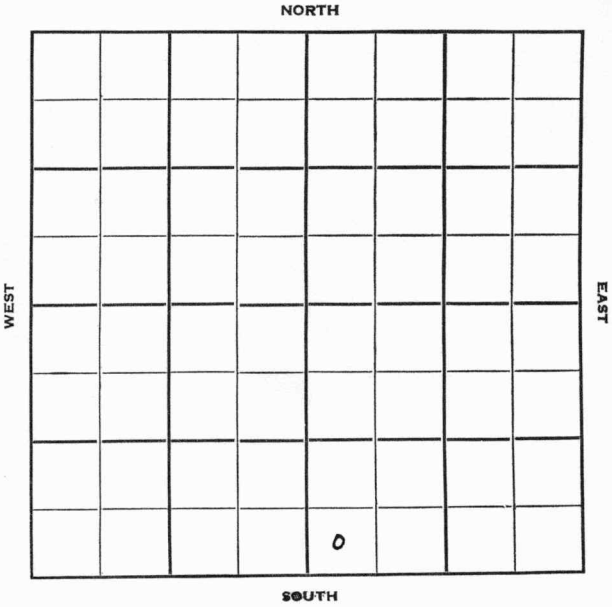

Sec. 2 Twp. 14 R. 20W

Well No. #2 Pfeifer "A" Farm

Sunray Company

Iron Drlg. - Contr. Contractor

Pleasant Pool


_____ Ft. from N. Line

330' Ft. from S. Line

_____ Ft. from E. Line

330' Ft. from W. Line

SW SW SE

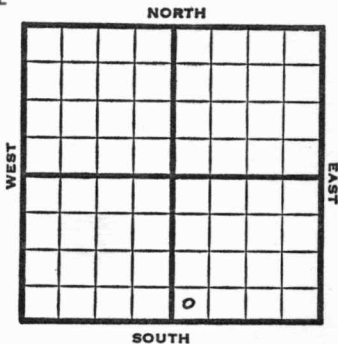

1951 Elev. 2217' REPORT

1/31 Spud 1-25-51
Anhy 1503
10" @ 1510
WOC

2/28 Spud 1-25-51
SWD Well TD 3944
Anhy 1503 10" @ 1510
Lans. 3532'
DST 3794-3825 opn 1 hr. Rec. 60' ocm
180' clean oil Sand 3851-54
sat. & odr
Gorham sand 3830 Arb. 3857
Gr Wash 3903
DST 3865-3944 opn 10 min
Rec. 1500' wtr 8" @ 3865
5000A TD 3944 Comp. for SWD

ABANDONED

