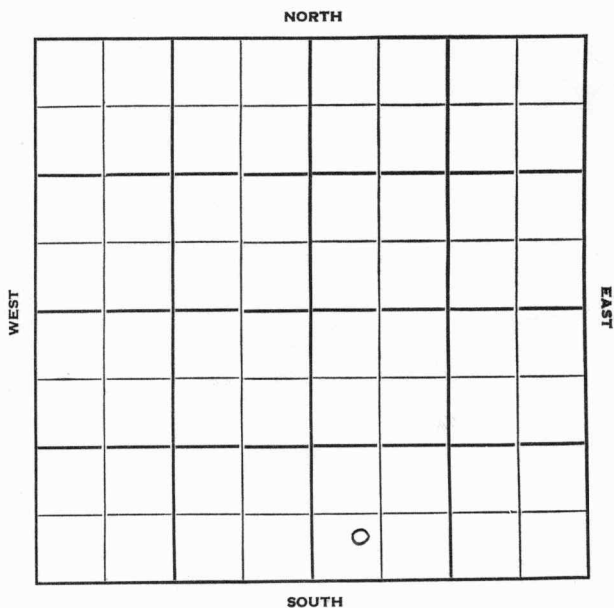


Section 2 Township 14 Range 20 WWell No. # 3 Pfeifer "A"Company Sunray Oil

Ellis

KANSAS

Sec. 2 Twp. 14 R. 20 W

Well No. # 3 Pfeifer "A" Farm

Sunray Oil Company

Stickle Drlg. Contractor

Pleasant Pool


Ft. from N. Line

390 Ft. from S. Line

Ft. from E. Line

405 Ft. from W. Line

SW SW SE (Twin well)

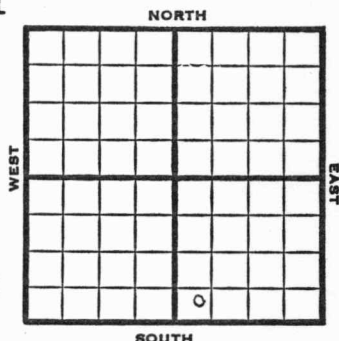

1951

Elev. 2223' REPORT

5/2

Location

6/27

Spud 5-6-51
Oil Well TD 3867
8" @ 1522
Lans. 3536
DST 3796- 3842 opn $\frac{1}{2}$ hr
Rec. 590' oil 60' mud
Arb. 3863 5" @ 3866
Gorham 2821
24/3820-25 Hydrafrac 3 boph 3 hr
Comp. 249 bopd

COMPLETED

J. E. TYRA

