



KANSAS

Ellis

Sec. 3 Twp. 14 R. 20W ✓

Well No. #1 Dinkle Farm  
White Eagle


Pleasant Pool (Helmerich & Payne, Cont.) Company

990' Ft. from N. Line

\_\_\_\_\_ Ft. from S. Line

330' Ft. from E. Line

\_\_\_\_\_ Ft. from W. Line

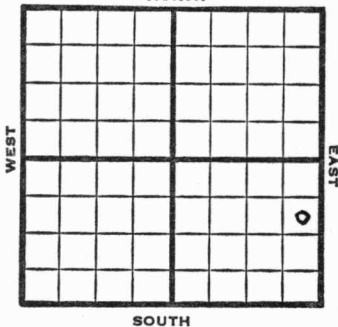

SE NE SE

1949

Elev. 2248' REPORT

6/8

8" @ 1284'

Drlg. 1973'

6/15

Drlg 3500'

6/22

Lans. 3540'

Arb. 3844'

Reagan 3872'

TD 3932'

**ABANDONED**

Ellis County Kansas State

Map No. Sec. 3 Twp. 14 R. 20W

Well No. 1 Dinkle

White Eagle Company

Helmerich & Payne Contractor

SE NE SE


FIRST REPORT SECTION PLAT

990 Ft. from N. Line

Ft. from S. Line

330 Ft. from E. Line


Ft. from W. Line

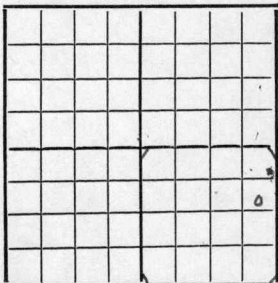

Pleasant Pool

Remarks:

8" @ 1284 drlg. 1973

 

Date JUN 8 1949

Scout S. J. LEWIS

Map No. A 70 Sec. 3 Twp. 14 R. 20W

Well No. 1 Dinkle

White Eagle Company

**ABANDONED**

Contractor

SE NE SE

*E 12248*


**SECTION PLAT**

990 Ft. from N. Line

\_\_\_\_\_ Ft. from S. Line

330 Ft. from E. Line

\_\_\_\_\_ Ft. from W. Line

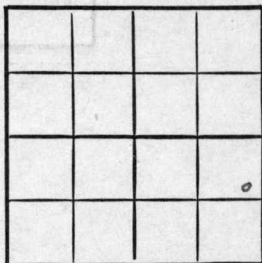

Ellis County

**RECORD**

Location \_\_\_\_\_

Cased \_\_\_\_\_ in., \_\_\_\_\_ ft.

Rig up \_\_\_\_\_

Sand \_\_\_\_\_

Drilling and Remarks: \_\_\_\_\_

Gas \_\_\_\_\_

Oil \_\_\_\_\_

Total Depth 3892

**PRODUCTION**

1st 24 hrs. Nat. \_\_\_\_\_

1st 24 hrs. after shot \_\_\_\_\_

Gas \_\_\_\_\_ Cu. Ft.

Dry Hole \_\_\_\_\_

Abandoned \_\_\_\_\_

*Hans 3540*  
*Cry 3544*  
*Ragon 3572*

Date

JUN 22 1949

19

S. J. LEWIS

Scout