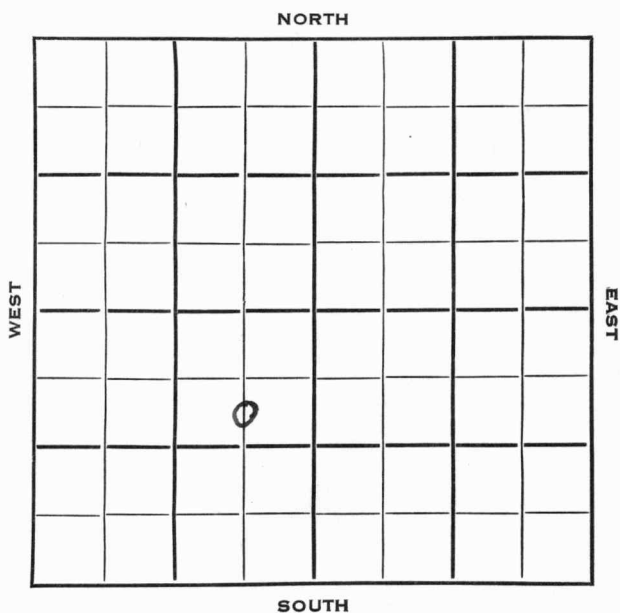


Section 2 Township 14 Range 20 WWell No. # 5 OrthCompany Sunray Oil

Ellis

KANSAS


Sec. 2 Twp. 14 R. 20 WWell No. # 5 Orth FarmSunray Oil CompanyStickle Drlg. ContractorPleasant Pool990 Ft. from N. Line

Ft. from S. Line

660 Ft. from E. Line

Ft. from W. Line

C S L NE SW

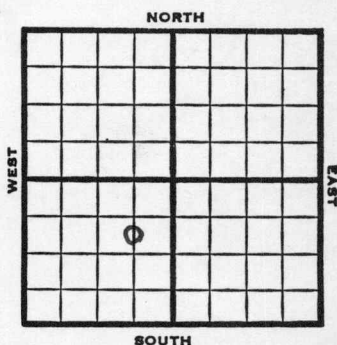

1953

Elev. 2243' REPORT

8/26

Cellar & Pits

9/2

8" @ 1527' w/1100 sks

Drlg 2170'

~~9/9~~

Drlg.

10/7

Spud 8-26-53 Oil well TD 3904'

8" @ 1527 Heeb 3471 Lans 3538

Marm. 3799

DST 3800-18 open 1 hr rec 45' OCM

540# Gorham 3831

DST 3818-40 open 1 hr rec 4' mud

DST 3840-54 open 1 hr rec 65' mud

640#

DST 3853-58 open 1 hr rec 70' HOCM

60' oil & wtr. 90% oil, 120' Wtr.

1100# Arb. 3861 Regan 3879


TD 3904' 5" @ 3903 24/3805-11

B/8-1/3 GOPH Sd-oil-frac. S/3 1/2 BO

1-3/4 BW 1 hr. P/21 BO 28 BW

Comp. 27 BOPD 41 BW

COMPLETED

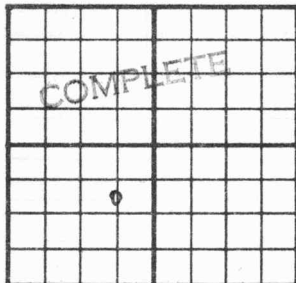County Ellis State KansasSec. 2 (Bk.
Twp.) 14 (Sur.
Rge.) 20W Map No.Operator Sunray OilWell No. 5 Farm OrthElev. 2243 Location C S L NE SW990 Ft. From N Line SW660 Ft. From E Line Quarter1st. ReportCompletion 001 7 1953Remarks Pleasant PoolStickle Drlg. - Contr.Spudding Date 8-26-53Drlg. Data Oil well TD 39048" @ 1527 Heeb. 3471 Lans. 3538Marm. 3799 DST 3800-18 open 1 hr.Rec. 45' ocm 540# Gorham 3831DST 3818-40 open 1 hr. Rec. 4' mudDST 3840-54 open 1 hr. Rec. 65' mud640# DST 3853-58 open 1 hr. Rec.70' hocm 60' oil & wtr. 90% oil120' wtr. 1100# Arb. 3861 Regan 3879TD 3904 5" @ 3903 24/ 3805-11B/ 8" 1/3 goph sd-oil-frac S/ 3 1/2 bo1 3/4 bw 1 hr. P/ 21 bo 28 bwComp. 27 bopd 41 bw

J. G. McGEHEE

Sec. 2 (Blk. Twp.) 14 (Sur. Rge.) 20W Map No.

Well No. 5 Farm Orth

Elev.	Location
	C S L NE SW

FIRST REPORT

A small circle is located in the lower-left quadrant of the grid, approximately at the intersection of the 4th vertical line and the 6th horizontal line from the top-left corner.

990 Ft. From N Line SW

660 Ft. From E Line Quarter

1st. Report AUG 26 1953

Completion

Remarks

Stickle Drlg. - Contr.

Spudding Date _____

Drlg. Data Pleasant Pool

Cellar & pits