


SECTION 3 TOWNSHIP 14 RANGE 20 W

WELL NO. #1 Dinkle

COMPANY Lewis Drlg.

NORTH

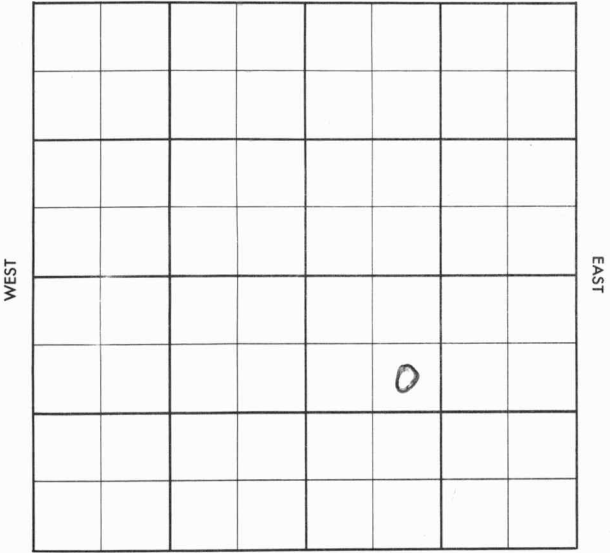

SOUTH

Ellis

KANSAS

SEC. 3 TWP. 14 R. 20 W

WELL NO.

1 Dinkle

FARM

COMPANY

Lewis Drlg.

CONTRACTOR

Co. tools


Wildcat

_____ Ft. from N. Line

_____ Ft. from S. Line

_____ Ft. from E. Line

_____ Ft. from W. Line

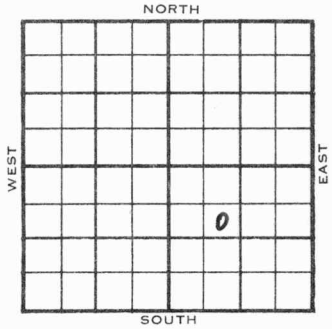

SE NW SE

SDX - 1/2 Mile

	ELEVATION	REPORT
1955	2234'	
12/21	Comm. 12-14-55 8" @ 250 Drlg. 2595' Anh. 1520'	
12-29	Heeb. 3466 Tor. 3489 BKC 3757 Drlg. 3805'	
<u>1956</u>		
1-6	Arb. 3873 TD 3886'	
1-12	DST 3550-69, op 1 hr. rec. 7' mud, 0# DST 3574-96, op 1 hr. rec. 450' vhocwm 1185# DST 3770-3815, op 1 hr. rec. 20' socm, 1260# DST 3800-20, op 1 hr. rec. 45' mud, 910# DST 3825-43, op 1/2 hr. rec. 20' mud, 80#	
1-18	D & A --- L. 3506 TD 3886'	

ABANDONED

County Ellis Elev. 2234
 Sec. 3 Twp. 14 Rge. 20W
 Company Lewis Drlg.
 Farm Name Dinkle No. 1

TOPS	DEPTH	LOG	DATUM
Anh.	1520		
T.P.			
H.			
Tr.			
Dg.			
Bl.			
L.			
K.C.			
B.K.C.			
Ce.			
C.			
M.			
M.			
K.			
Mz.			
Me.			
V.			
S.			
S.			
A			
R.			
Pe.			
G.			
T.D.			

Loc. in Sec. SE NW SE

Geol. _____
 Contr. _____
 Co. tools _____

Pool Wildcat

SDX - 1/2 mile

FIRST REPORT

DEC 21 '55

Date Comm. 12-14-55
8" @ 250 drlg. 2595

PLEASANT

Co.

Lse.

No.

Sec.

T.

R.

County Ellis Elev. 2234
 Sec. 3 Twp. 14 Rge. 20W
 Company Lewis Drlg.
 Farm Name Dinkle No. 1

TOPS	DEPTH	LOG	DATUM
Anh.	1520		
Tp.			
H.	3466	3463	
Tr.	3489	3484	
Dg.			
Bl.			
L.	3506	3503	1269
K.C.			
B.K.C.	3757	3753	1519
Ce.			
C.			
M.			
M.			
K.			
Mz.			
Me.			
V.			
S.			
S.			
A	3873	3872	1638
R.			
PE.			
G.			
T.D.	3886		

Loc. in Sec. SE NW SE
 Geol. _____
 Contr. _____
 Co. tools _____
 Pool Wildcat



Date Comm. 12-14-55 JAN 18 1956
8" @ 250 DST 3550-69 open 1 hr.

rec. 7' mud 0# DST 3574-96
open 1 hr. rec. 450' vhocwm 1185#
DST 3700-15 open 1 hr. rec. 20' socm
1260# DST 3700-20 open 1 hr. rec.
45' mud 910# DST 3825-43 open 1/2 hr.
rec. 20' mud 80#

D & A