


Company Chas. T. Judd (Commerce Drlg. Co.) Svc. 25 T. 10 E. 23 E *Plot 114*
 Loc. 340 S-1000'W of NEC

Farm Jaggard No. 1

(nw ne ne)
 25-10-23E

Total Depth 532
 Comm.
 Shot or Treated
 Contractor
 Issued

Comp. 6/14/30

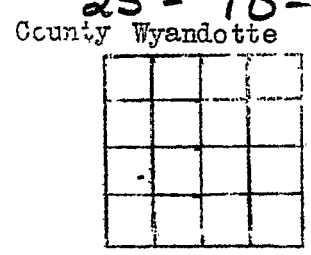

Casing
 20 in. 10 in.
 15 1/2 8 1/4
 12 1/2 6 ~~5 1/2~~ 1/4 -- 386
 13 3/8 5 3/16

Elevation 888

Production Gas well
 (Est. 150,000 cu. ft.)

Figures Indicate Bottom of Formation

soil	1	shale grey	487
lime boulders	15 Plattsburg	lime	489
shale blue	32	shale grey	499
lime	45	shale black	504
shale grey	48	shale grey	510
lime	58	lime white	513
shale grey	88	lime sandy	516
lime	115 Iola	shale black	520
shale grey	125	shale white	524
lime	129	lime	526
shale grey	131	shale white	530
lime	133	lime	532
shale grey	145	sand	gas
lime	153		
shale grey	158		T.D.
lime	165		
shale grey	187		
lime	190		
slate black	195		
lime	198		
slate black	201		
lime	224		
slate black	230 Water		
lime	264		
shale grey	370		
sand	375		
shale grey	377		
red bed	381		
lime	386		
shale grey	406		
lime	407		
shale sandy	420		
sand	430 - Perm? 10		
lime	433		
shale black	440		
shale grey	445		
lime	453		
sand	460 Show of gas Perm 7'		
shale dark	471		
lime	475		
slate black	480 water & show of gas		