

KANSAS


FORM 51 5M BR1X

Ellis County

Section 3 Township 14 Range 20W

Well No. #1 Dinkel

Company Sunray

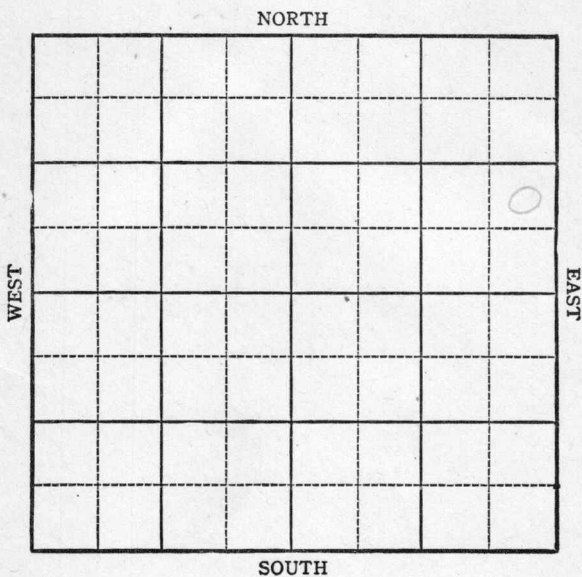

KANSAS Ellis County

Sec. 3 Twp. 14 R. 20W

Well No. #1 Dinkel Farm

Sunray Company


Pleasant

\_\_\_\_\_ Ft. from N. Line

990 Ft. from S. Line

330 Ft. from E. Line

\_\_\_\_\_ Ft. from W. Line

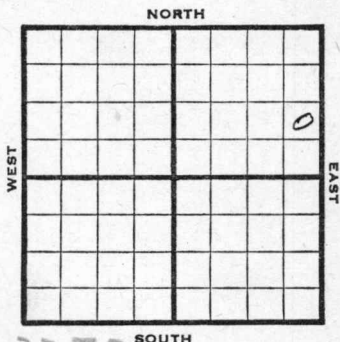

~~NE SE NE~~

*Elev. 2273*

1944

R E P O R T

- 11/8 Anhy 1557  
8" @ 1654' WOC
- 11/16 Drlg. 3300'
- 11/24 Heebner 3504 Lans 3572 Bkc 3804  
Cong 3878 Reagan 882 TD 3889  
SSO 5" @ 3882 RUST
- 11/29 No Reagan Arb. 3903 TD 3925 H. F. W.  
12/6 Slm. 3889-86  
BKC 3801  
Cong. 3878  
Arb. 3903  
TD 3925'  
800' Water per hr.
- 12/14 " " " " " " " "
- 12/21 " " " " " " " "
- 12/29 " " " " " " " "

1945

1-3 Arbuckle 3903  
Total Depth 3925  
Water.

ABANDONED



