


Section 10 Township 14 Range 20W

Well No. #1 Herman

Company Surray

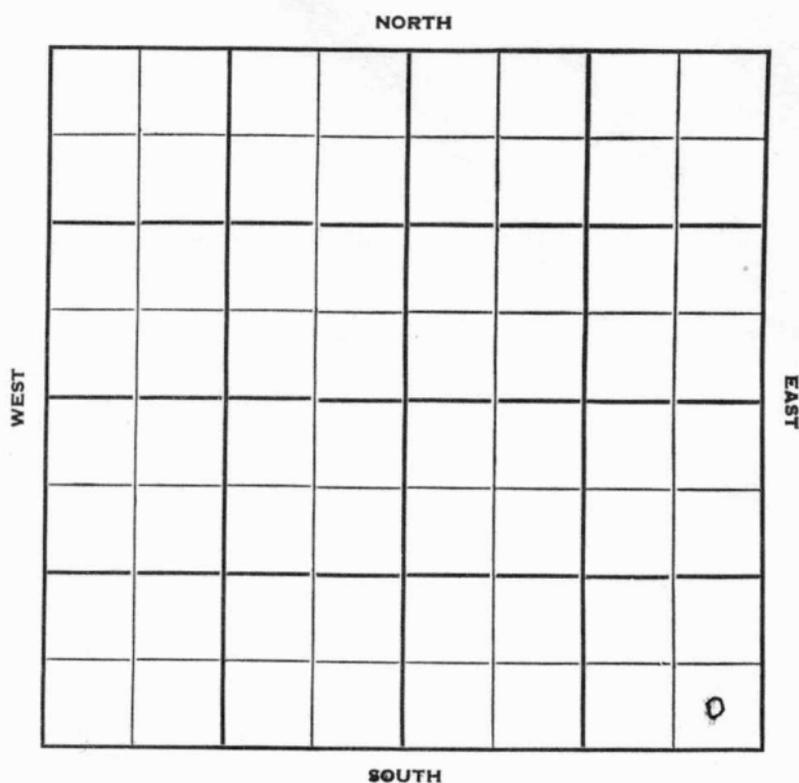

Ellis

KANSAS

Sec. 10 Twp. 14 R. 20W

Well No. #1 Herman Farm

Sunray Company

Stickle Drlg. - Contr. Contractor

Pleasant Pool


_____ Ft. from N. Line

330' Ft. from S. Line

330' Ft. from E. Line

_____ Ft. from W. Line

SE SE SE

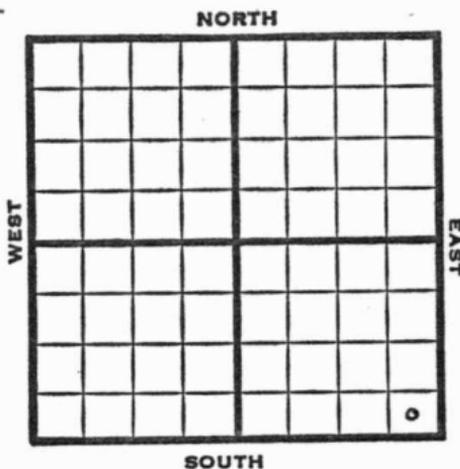

1951

Elev. 2160'

REPORT

4/18

Location

5/9 Spud 4-19-51
 D & A TD 3859'
 8" @ 1472' Heeb 3412' Tor. 3433'
 Lans. 3454', B KC 3702' Mar. 3747'
 Cong. 3776' Arb. 3793'
 DST 3794-3801' open 1 hr. rec 20' mud
 2' free oil
 Regan 3829-59' TD
 D & A

ABANDONED


County Ellis State Kansas

Sec. 10 (^{Blk.}Twp.) 14 (^{Sur.}Rge.) 20W Map No.

Operator Sunray

Well No. 1 Farm Herman

Elev. 2160 Location SE SE SE

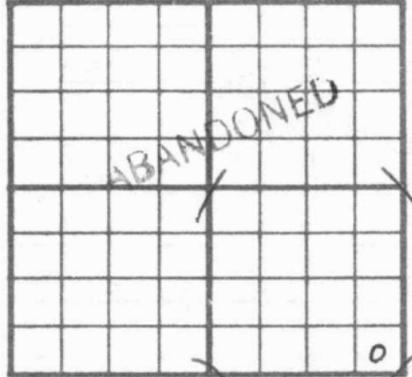

330 Ft. From S Line SE
330 Ft. From E Line Quarter

Ist. Report

Completion MAY 9 1951

Remarks Wildcat

Stickle Drlg. - Contr.

Spudding Date 4-19-51

Drlg. Data D & A TD 3859

8" @ 1472 Heeb. 3412 Tor. 3433

Lans. 3454 B KC 3702 Mar. 3747

Cong. 3776 Arb. 3793 DST 3794-3801

open 1 hr. Rec. 20' mud 2' free oil

Regan 3829-59 TD

D & A