

KANSAS Ellis

Section 10 Township 14 Range 20WWell No. 1 PfannenstielCompany Sunray

Pleasant Pool

NORTH

							O

WEST

EAST

SOUTH

KANSAS

Ellis

Sec. 10 Twp. 14 R. 20W

Well No. #1 Pfannenstiel Farm

Sunray Company
Pleasant Pool


330' Ft. from N. Line

Ft. from S. Line

330' Ft. from E. Line

Ft. from W. Line

NE/C

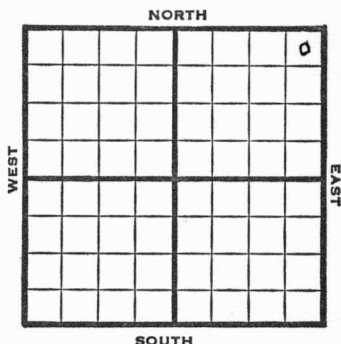

1948 Elev. 2221' REPORT

8/18 8" @ 275'
Drlg. 2250'
8/25 Drlg 3325'
9/1 Lansing 3519'
BKC 3750'
Arbuckle 3818'
TD 3824'
5" @ 3819'
9/8 Swb 5 bbls oil PH
9/14 Pump 67 bbls oil 8 hrs.
9/22 Arbuckle 3818'
5" @ 3819'
TD 3824'
Pump 133 oil Pot.
Gr. 250
COMPLETED

Ellis County Kansas State

Map No. _____ Sec. 10 Twp. 14 R. 20W

Well No. 1 Pfannenstiel

Sunray Company

FIRST REPORT Contractor

NE/C

SECTION PLAT

330 Ft. from N. Line

_____ Ft. from S. Line

330 Ft. from E. Line


_____ Ft. from W. Line

Pleasant Pool

Remarks:

8" @ 275

drlg. 2250

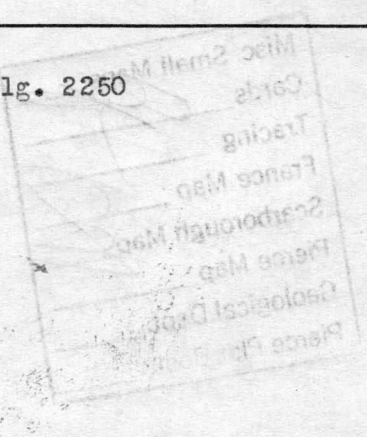

Date

AUG 1 8 1948

Scout

S. J. LEWIS

Ellis County Kansas State

Map No. 20 Sec. 10 Twp. 14 R. 20W

Well No. 1 Pfannenstiel

Sunray Company

COMPLETE

Contractor

NE/C

E12221

SECTION PLAT

							0

330 Ft. from N. Line

 Ft. from S. Line

330 Ft. from E. Line

 Ft. from W. Line

Pleasant Pool

Remarks:


Cur 3818

5" 3819

7 3824

Pump 133 oil 25

25 2 1/2

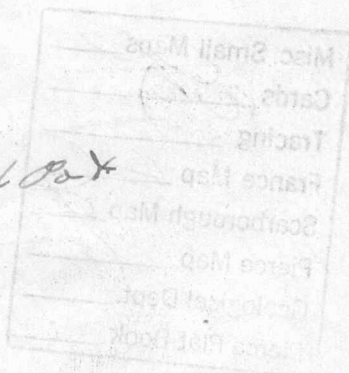

Date
SEP 22 1948

Scout
S. J. LEWIS