

Ellis

KANSAS


Section 11 Township 14 Range 20-W

Well Number 1 Befort

Company Sunray Oil et al

Special

NORTH

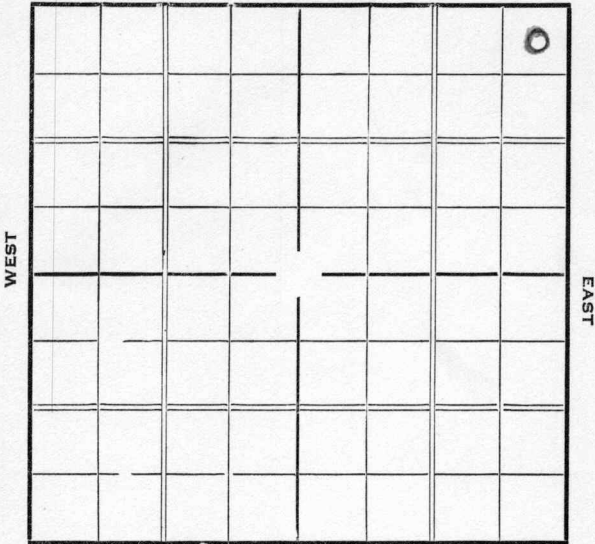

SOUTH

Map No. \_\_\_\_\_ Sec. 11 Twp. 14 R. 20-W

Well No. #1 Befort Farm \_\_\_\_\_


Sunray Oil et al Company \_\_\_\_\_

330 Ft. from N. Line

\_\_\_\_\_ Ft. from S. Line

330 Ft. from E. Line

\_\_\_\_\_ Ft. from W. Line

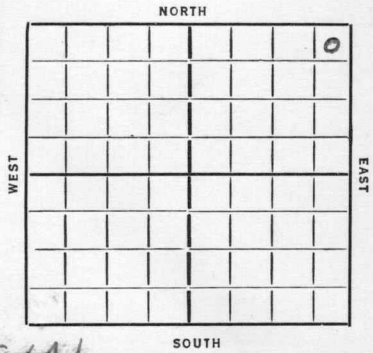

SPECIAL *SPECIAL*

Date	REPORT
<u>1936</u>	<u>Elev. 2237</u>
<u>12/16</u>	<u>Location</u>
<u>12/24</u>	<u>Rigging up</u>
<u>12/29</u>	<u>Rigging up cable rig.</u>
<u>1937</u>	
<u>1/7</u>	<u>15" @ 732'.</u>
<u>1/14</u>	<u>Drlg. 982'.</u>
<u>1/21</u>	<u>Fishing 1315'.</u>
<u>1/28</u>	<u>Drlg. 1500'.</u>
<u>2/4</u>	<u>Anhydrate 1530 Drlg 1680</u>
<u>2/11</u>	<u>13" @ 1534 Drlg. 2570'.</u>
<u>2/19</u>	<u>8" @ 2878 Drlg. 2900'</u>
<u>2/26</u>	<u>Drlg. 3245'</u>
<u>3/4</u>	<u>Topeka 3252'. 6" @ 3234'.</u>
	<u>KCL 3545'. 3550' under ream 6"</u>
<u>3/11</u>	<u>6" @ 3528'. T.D. 3550'</u>
	<u>Underream 6"</u>
<u>3/18</u>	<u>6" @ 3549 KCL 3555'</u>
	<u>Conglomerate 3784</u>
	<u>Drlg. 3800'</u>

OVER

1937

3/25 Conglomerate 3830' (Corrected)  
Basil sand 3887'. Drlg. 3902'.

4/2 Total Depth 3902'. Shut Down.

4/7 Sil. 3900'.

T. D. 3914'.

**ABANDONED**

Map No. 70 Sec. 11 Twp. 14 R. 20W

Well No. 1 Beyond

Sunray Oil & Gas Company  
Contractor

# Special

## SECTION PLAT

330 Ft. from N. Line  
\_\_\_\_\_ Ft. from S. Line  
330 Ft. from E. Line  
\_\_\_\_\_ Ft. from W. Line

			0

## FIRST REPORT

Location ✓

Rig up \_\_\_\_\_

Drilling and Remarks:

## RECORD

Cased \_\_\_\_\_ in., \_\_\_\_\_ ft.

Sand \_\_\_\_\_

Gas \_\_\_\_\_

Oil \_\_\_\_\_

Total Depth \_\_\_\_\_

## PRODUCTION

1st 24 hrs. Nat. \_\_\_\_\_

1st 24 hrs. after shot \_\_\_\_\_

Gas \_\_\_\_\_ Cu. Ft.

Dry Hole \_\_\_\_\_

Abandoned \_\_\_\_\_

Date

DEC 16 1936

19 \_\_\_\_\_

S. J. LEWIS Scout

Map No. \_\_\_\_\_ Sec. 11 Twp. 14 R. 20W

Well No. 1 Bayot

Sunray Oil & Gas Company

Contractor

**SECTION PLAT**

			○

330 Ft. from N. Line

\_\_\_\_\_ Ft. from S. Line

330 Ft. from E. Line

\_\_\_\_\_ Ft. from W. Line

ABANDONED

Location \_\_\_\_\_

Rig up \_\_\_\_\_

Drilling and Remarks:

*Sil 3900*

**RECORD**

Cased \_\_\_\_\_ in., \_\_\_\_\_ ft.

Sand \_\_\_\_\_

Gas \_\_\_\_\_

Oil \_\_\_\_\_

Total Depth 3914

**PRODUCTION**

1st 24 hrs. Nat. \_\_\_\_\_

1st 24 hrs. after shot \_\_\_\_\_

Gas \_\_\_\_\_ Cu. Ft.

Dry Hole

Abandoned

Date

APR 7 1937 19

S. J. LEWIS Scout