


Section 11 Township 14 Range 20W

Well No. #1 Berfort

Company C.E. Skiles

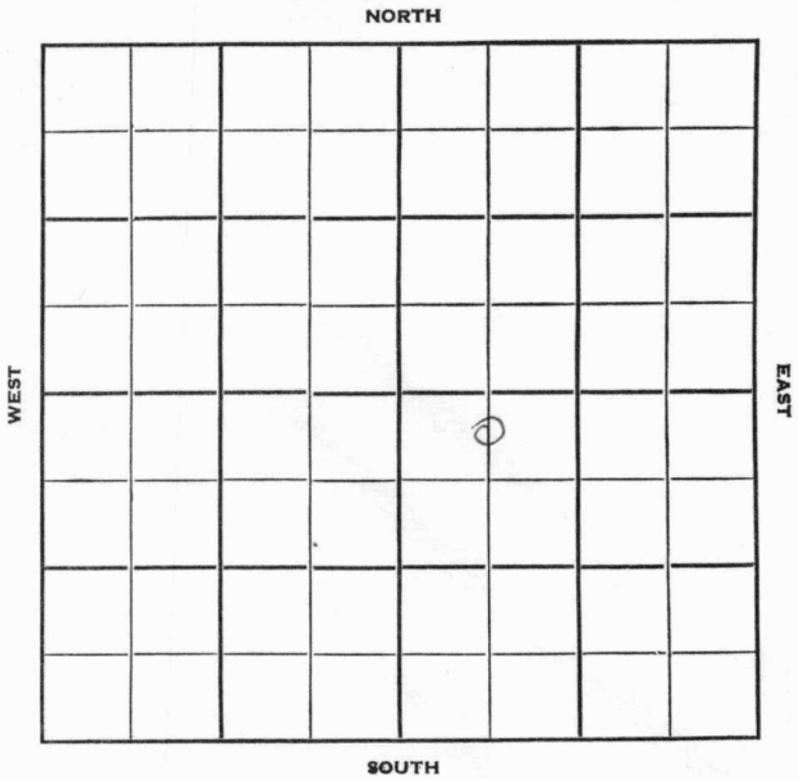

Sec. 11 Twp. 14 R. 20 W

Well No. # 1 Berfort Farm

C. E. Skiles Company

C. E. Skiles Contractor
Wildcat


330 Ft. from N. Line

_____ Ft. from S. Line

_____ Ft. from E. Line

660 Ft. from W. Line

C N/2 NW SE

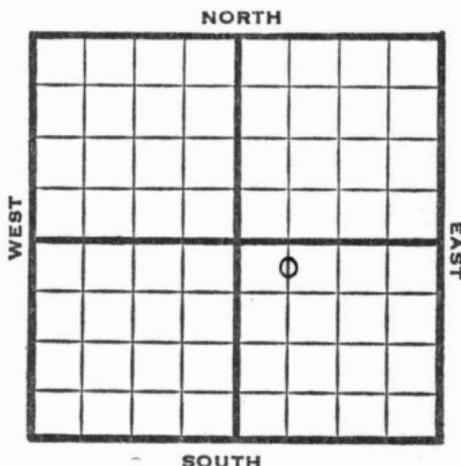

1951

Elev. 2207'

REPORT

11/14

Spud 11-2-51

8" @ 163

Anhy 1500'

Drlg. 2229'

Lans. 3501'

DST 3524-32' open $\frac{1}{2}$ hr. rec. 15' mud.

DST 3558-67 open $\frac{1}{2}$ hr. rec. 20' mud.

Drlg. 3660'

1952

1/23

Spud 11-2-51

Oil Well TD 3856

8" @ 163

Anhy 1500 Lans. 3501

DST 3524-32 opn $\frac{1}{2}$ hr. Rec. 15' mud

DST 3558-67 opn $\frac{1}{2}$ hr. Rec. 20' mud

Cong. 3772

DST 3780-3803 opn 2 hr.

Rec. 28' mud

Gorham Sand 3816

DST 3820-56 opn 23 min.

Rec. 1080' ocm

5" @ 3855 CO to 3851

24/3846-51 500 A S/5 boph 12 hr.

Marm. 3790 Arb. 3820

Comp. 50 bopd

COMPLETED

County **Ellis** State **Kansas**

Sec. **11** (Blk. **14** (Sur. **20W** Map No. (Twp. **14** (Rge. **20W**)

Operator **C. E. Skiles**

Well No. **1** Farm **Berfort**

Elev. **2207** Location **C N/2 NW SE**

330 Ft. From N Line SE

660 Ft. From W Line Quarter

Ist. Report **NOV 14 1951**

Completion

Remarks

C. E. Skiles - Contr.

Spudding Date **11-2-51**

Drlg. Data **Wildeat**


8" @ 163 Anhy 1500 Drlg. 2229

Lans. 3501 DST 3524-32 Open $\frac{1}{2}$ hr.

Rec. 15' mud DST 3558-67 open $\frac{1}{2}$ hr.

Rec. 20' mud drlg. 3660

J. E. TYRA

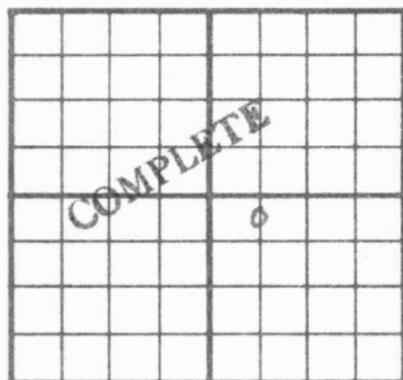County Ellis State KansasSec. 11 (Blk. 14) (Sur. 20W) (Twp.) (Rge.) Map No.Operator C. E. SkilesWell No. 1 Farm BerfortElev. 2207 Location C N L NW SE330 Ft. From N Line SE660 Ft. From W Line Quarter

1st. Report

Completion JAN 23 1952Remarks WildcatSkiles - Contr.Spudding Date 11-2-51Drlg. Data Oil well TD 38568" @ 163 Anhy 1500 Lans. 3501DST 3524-32 open $\frac{1}{2}$ hr. Rec. 15' mudDST 3558-67 open $\frac{1}{2}$ hr. Rec. 20' mudCong. 3772 DST 3780-3803 open 2 hr.Rec. 28' mud Gorham sand 3816 DST 3820-56 open 23 min. Rec. 1080' ocm5" @ 3855 CO to 3851 24/ 3846-51500 A S/ 5 boph 12 hr. Marm. 3790Arb. 3820 Comp. 50 bopd

J. G. McGEHEE