


Sawley

Form 51-5M-4-27-27/23

Map No. KANSAS Sec. 7 Twp. 34 R. 3E

Well No. 1 - Kemp Barnsdall et al Farm Company

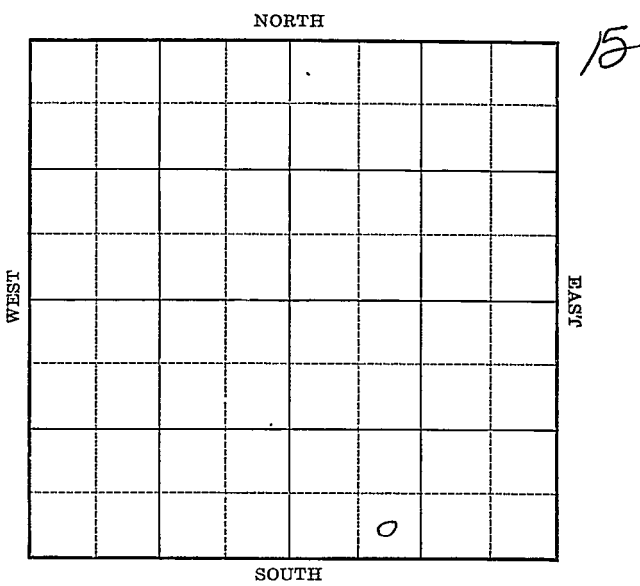

Location \_\_\_\_\_

Drilling Remarks \_\_\_\_\_

\_\_\_\_\_

\_\_\_\_\_

RECORD

Cased \_\_\_\_\_ in. \_\_\_\_\_ ft.

Sand \_\_\_\_\_

Gas \_\_\_\_\_

Oil \_\_\_\_\_

Total Depth \_\_\_\_\_

Rig Up \_\_\_\_\_

Drilling Remarks \_\_\_\_\_

\_\_\_\_\_

\_\_\_\_\_

PRODUCTION

1st 24 hrs. Nat. \_\_\_\_\_

1st 24 hrs. after shot \_\_\_\_\_

Gas \_\_\_\_\_ cu. ft.

Dry Hole \_\_\_\_\_


Abandoned \_\_\_\_\_

*Cowley*

Map No. **KANSAS** Sec. 7 Twp. 34 R. 3<sup>E</sup>

Well No. 1 - Kemp Farm  
Barnsdall Oil Coal Company

..... Ft. from N. Line  
330 Ft. from S. Line  
 ..... Ft. from E. Line  
990 Ft. from W. Line

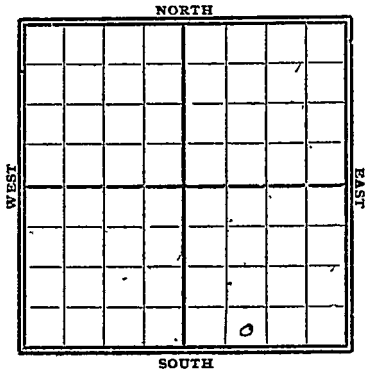

1928

Date	REPORT
10/3	Rig Bldg.
10/10	Rig
10/17	20" @ 82'
10/24	Drlg 895'
10/31	" 1680'
11/7	" 2200'
11/14	" 2325'
11/21	" 2475'
11/28	6" at 2900'
	Drlg 2935'
12/5	" 3000'
12/12	2 At gas 3350 - 52 drlg
12/19	Chat 3390 - drlg 3400'
12/26	drlg 3420'
1929	
1/2	" 3440'
1/9	" 3450'
1/16	" 3486'
1/23	" 3538'
1/30	" 3610'
2/6	Stilcoy 3759-65'
	drlg 3768'

2/13 - Siliceous level  
at 3790-3814'  
T.D. 3814' - HFW  
Dry & Abandoned

MAP NO. KT **KANSAS** SEC. 7 TWP. 34 R. 3E

WELL NO. 1 Kemp

Barnwell Oil & Gas COMPANY

CONTRACTOR

SECTION PLAT


\_\_\_\_\_ FT. FROM N. LINE

830 FT. FROM S. LINE

\_\_\_\_\_ FT. FROM E. LINE

990 FT. FROM W. LINE

FIRST REPORTS

RECORD

LOCATION \_\_\_\_\_

CASED \_\_\_\_\_ IN. \_\_\_\_\_ FT.

RIG UP \_\_\_\_\_

SAND \_\_\_\_\_

DRILLING AND REMARKS:

GAS \_\_\_\_\_

*Rig & culling*

OIL \_\_\_\_\_

TOTAL DEPTH \_\_\_\_\_

PRODUCTION

1ST 24 HRS. NAT. \_\_\_\_\_

1ST 24 HRS. AFTER SHOT \_\_\_\_\_

GAS \_\_\_\_\_ CU. FT.

DRY HOLE \_\_\_\_\_

ABANDONED \_\_\_\_\_

DATE

OCT 3 1928

S. J. LEWIS

192

SCOUT

MAP NO. 177A 1000 SEC. 7 TWP. 34 R. 3E

WELL NO. K1 1 Kemp

Barnwell Oil & Gas COMPANY

CONTRACTOR

SECTION PLAT

			0

\_\_\_\_\_ FT. FROM N. LINE

320 FT. FROM S. LINE

\_\_\_\_\_ FT. FROM E. LINE

990 FT. FROM W. LINE

ABANDONED

LOCATION \_\_\_\_\_

RIG UP \_\_\_\_\_

DRILLING AND REMARKS:

Sil Linn 8790  
3814 HPN

ITF

RECORD

CASED \_\_\_\_\_ IN., \_\_\_\_\_ FT.

SAND: \_\_\_\_\_

GAS \_\_\_\_\_

OIL \_\_\_\_\_

TOTAL DEPTH 3814

PRODUCTION

1ST 24 HRS. NAT. \_\_\_\_\_

1ST 24 HRS: AFTER SHOT \_\_\_\_\_

GAS \_\_\_\_\_ CU. FT.

DRY HOLE \_\_\_\_\_

ABANDONED \_\_\_\_\_

DATE

FEB 13 1929

C. J. LIMS