


Section 7 Township 34 Range 3E

Well No. 1 Tuttle

Company Kanotex

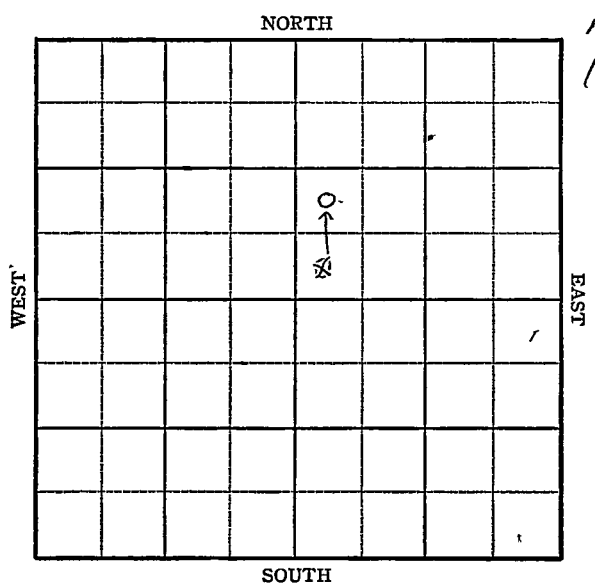

KANSAS Cowley

Sec. 7 Twp. 34 R. 3-E

Well No. #1 Tuttle Farm


Kanotex Company

990 Ft. from N. Line

330 Ft. from S. Line

330 Ft. from E. Line

330 Ft. from W. Line

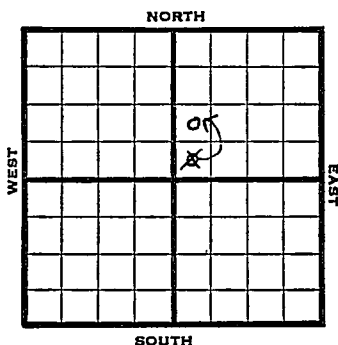

NW SW NE Elev. 1137

1945

REPORT

9/5	Drlg. 120'
9/12	10" @ 157 Drlg. 2020
9/19	KC 2885 Drlg. 300.
9/26	Bart. 3379 TD 3403 Sat. 5" @ 3379 WOC
10/3	" " "
10/10	3000' oil 36 hrs.
10/17	Miss. 3400 TD 3404'
10/24	Shut down
10/31	" "
11/7	" "
11/14	20 qts. 3377-3399 No help
11/21	Miss. 3400 5" @ 3379 TD 3404 Flow 8 oil Pot. Grav. 36.0

COMPLETE

KANSAS

Kansas Pool Name MiscellaneousMap No. 1 Sec. 7 Twp. 3 4 R. 3 EWell No. 1 TuttleKanotex

Company

FIRST REPORT

Contractor

SW NE

SECTION PLAT

 Ft. from N. Line330 Ft. from S. Line Ft. from E. Line330 Ft. from W. Line

Cowley County

		D	

Location Rig up

Drilling and Remarks:

120'

RECORD

Cased in., ft.Sand Gas Oil Total Depth

PRODUCTION

1st 24 hrs. Nat. 1st 24 hrs. after shot Gas Cu. Ft.Dry Hole Abandoned

Date

SEP 5 1945

19

S. J. LEWIS Scout

KANSASPool Name Miscellaneous~~Kansas~~Map No. 1 Sec. 7 Twp. 34 R. 3EWell No. 1 TuttleKanotex

Company

CORRECTION

Contractor

NW SW NE

SECTION PLAT

		o	

Ft. from N. Line990Ft. from S. LineFt. from E. Line330Ft. from W. LineCowleyLocation Rig up

Drilling and Remarks:

reported SW NE

RECORDCased in., ft.Sand Gas Oil Total Depth **PRODUCTION**1st 24 hrs. Nat. 1st 24 hrs. after shot Gas Cu. Ft.Dry Hole Abandoned

Date

SEP 19 1945

19

S. J. LEWIS

Scout

KANSAS

Kansas

Pool Name MiscellaneousMap No. 1 Sec. 7 Twp. 34 R. 3EWell No. 1 TuttleKanotex Company

COMPLETED

Contractor

NW SW NE

E1, 1/87
SECTION PLAT

		o	

 Ft. from N. Line990 Ft. from S. Line Ft. from E. Line330 Ft. from W. LineCowley County.Location Rig up

Drilling and Remarks:

Miss 34005" C3379Flow to oil BX362/yr

RECORD

Cased in., ft.Sand Gas Oil Total Depth 3404

PRODUCTION

1st 24 hrs. Nat. 1st 24 hrs. after shot Gas Cu. Ft.Dry Hole Abandoned

Date

NOV 21 194519S. J. LEWISScout