

# KANSAS


Cowley

Form 51-5M-7-39-Palace

Section 8 Township 34 Range 3E

Well No. #1 Bahruth

Company E. B. Shawver

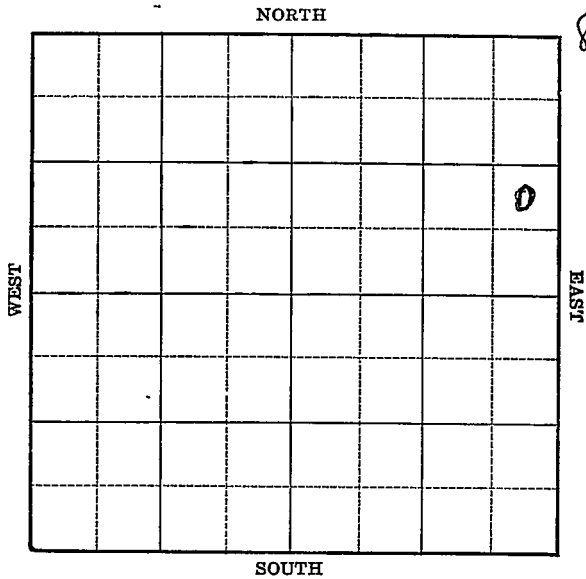



Map No.        /        Sec. 8 Twp. 34 R. 3EWell No. 1 BahruthE. B. Shawver Company

Contractor

**FIRST REPORT**

NE SE NE

       Ft. from N. Line990 Ft. from S. Line330 Ft. from E. Line       Ft. from W. Line

Gueda Spring Pool

**SECTION PLAT**


Location       Rig up       

Drilling and Remarks:

13" - 134Drig, 1540**RECORD**Cased        in.,        ft.Sand       Gas       Oil       Total Depth       **PRODUCTION**1st 24 hrs. Nat.       1st 24 hrs. after shot       Gas        Cu. Ft.Dry Hole       Abandoned       

Date

7-2-1940S. J. LEWIS Scout

