


Section 4 Township 17 Range 1 W

Well No. # 5⁶ Buckey

Company F. S. Williams

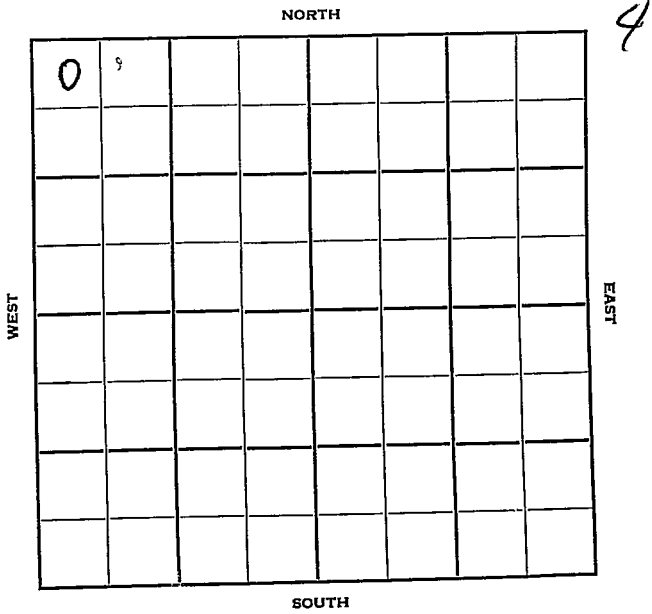

Sec. 4 Twp. 17 R. 1W

Well No. #9 ~~#2~~ Buckey Farm

F. S. Williams Company

Mallard Drlg. Contractor


330 Ft. from N. Line

_____ Ft. from S. Line

_____ Ft. from E. Line

330 Ft. from W. Line

NW NW NW

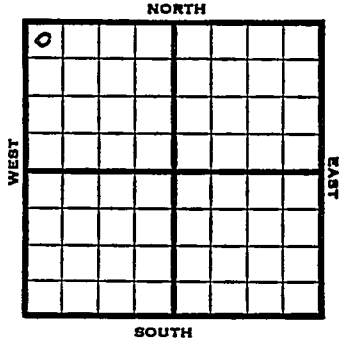

1953 Elev. 1281' REPORT

4/15 Location

4/23 8" @ 131 Br li 1945' KC 2003'
Miss 2604' RTD 2606' 5" @ 2505

4/30 NR

5/6 Spud 4-18-53
Oil Well
TD 2618
8" @ 131
Br lime 1945, KC 2003, Miss 2604
TD 2606
5" @ 2605
DD 2618
S/1 bfph 50% wtr. 1000A
S/7 bfph 50% wtr.
Comp. 25 bopd 25 bw

COMPLETED

County McPherson State Kansas

Sec. 4 (Blk. 17) (Sur. 1W) (Twp.) (Rge.) Map No.

Operator F. S. Williams

Well No. 5 Farm Buckey

Elev. _____ Location NW NW NW

0					

330 Ft. From N Line NW

330 Ft. From W Line Quarter

1st. Report APR 15 1953

Completion _____

Remarks _____

Mallard Drig. - Contr.

Spudding Date _____

Drig. Data _____

Location _____

ADJUS

Map No. _____ Sec. 4 Twp. 17 R. 1W

Well No. 6 Buckey

F. S. Williams Company

CORRE Contractor

NW NW NW

330 Ft. from N. Line

_____ Ft. from S. Line

_____ Ft. from E. Line

330 Ft. from W. Line

SECTION PLAT

0			

McPherson County

Location _____

Rig up _____

Drilling and Remarks:

Reported
#5 Buckey

RECORD

Cased _____ in., _____ ft.

Sand _____

Gas _____

Oil _____

Total Depth _____

PRODUCTION

1st 24 hrs. Nat. _____

1st 24 hrs. after shot _____

Gas _____ Cu. Ft.

Dry Hole _____

Abandoned _____

Date

MAY 6 1953 19

J. G. MCGEHEE Scout

