

KANSAS

Section 4 Township 17 Range 1WWell No. 5 Bukey "B"Company Nichol Chapro et al

Henne Pool

NORTH

	6						

WEST

EAST

SOUTH

KANSAS

McPherson

Sec. 4 Twp. 17 R. 1W

Well No. #5 Bukey "B" Farm

Nichol Chapiro et al Company

Henne Pool


990' Ft. from N. Line

 Ft. from S. Line

 Ft. from E. Line

990' Ft. from W. Line

SE NW NW

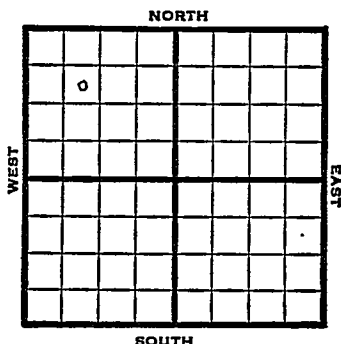

1949

Elev. 1284' REPORT

2/2

8" @ 125'
Drlg. 2230'

2/9

Lansing 2005' Mississippi 2609'
TD 2611'
5" @ 2610'

2/16

Miss 2609'
TD 2626'

ABANDONED

Map No. _____ Sec. 4 Twp. 17 R. 1W

Well No. 5 Bukey "R"

Nichol Chapro et al. Company

FIRST REPORT Contractor

SE NW NW


SECTION PLAT

990 Ft. from N. Line

_____ Ft. from S. Line

_____ Ft. from E. Line

990 Ft. from W. Line

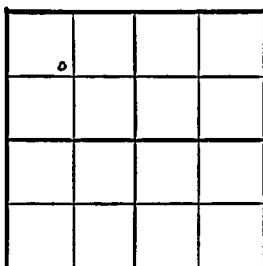

McPherson County

Location _____

Rig up _____

Drilling and Remarks:

8" @ 125

drlg. 2 230

RECORD

Cased _____ in., _____ ft.

Sand _____

Gas _____

Oil _____

Total Depth _____

PRODUCTION

1st 24 hrs. Nat. _____

1st 24 hrs. after shot _____

Gas _____ Cu. Ft.

Dry-Hole _____

Abandoned _____

Date

FEB 2 1949 19

S. J. LEWIS Scout

Map No. K42 Sec. 4 Twp. 17 R. 1W

Well No. 5 Bukey "B"

Nichol Chapro et al. Company

ABANDONED

Contractor

SE NW NW


E 1/2 84
SECTION PLAT

990 Ft. from N. Line

 Ft. from S. Line

 Ft. from E. Line

990 Ft. from W. Line

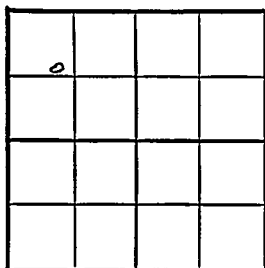

McPherson County

Location

Rig up

Drilling and Remarks:

Min 2609

RECORD

Cased in., ft.

Sand

Gas

Oil

Total Depth 2626

PRODUCTION

1st 24 hrs. Nat.

1st 24 hrs. after shot

Gas Cu. Ft.

Dry Hole

Abandoned

Date

FEB 16 1949 19

S. J. LEWIS Scout