


Section 28 Township 14 Range 12 W

Well No. # 1 Gray

Company Duke & Wood

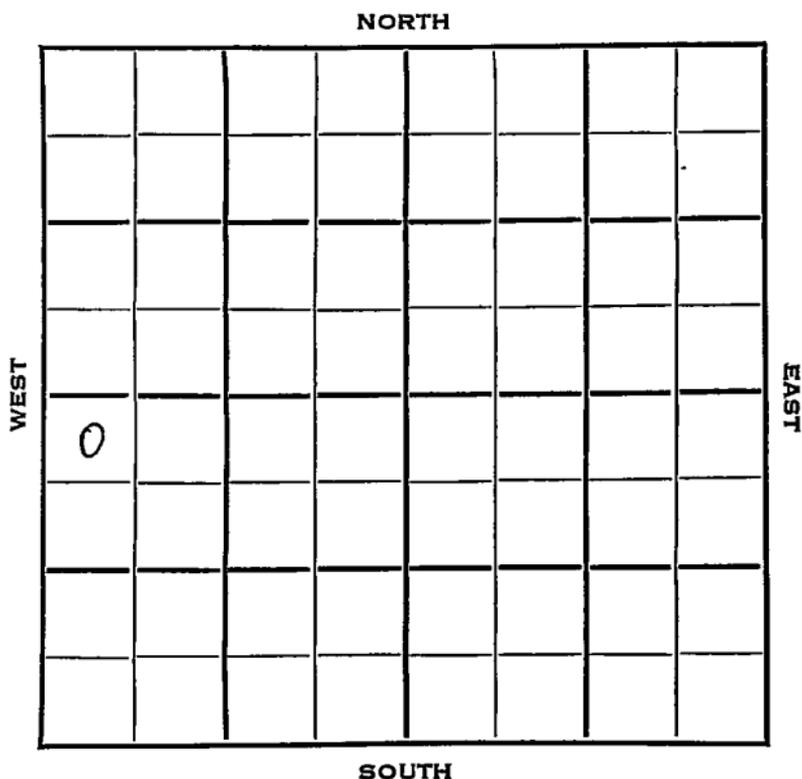

Russell KANSAS


SEC.	TWP.	R.
28	14	12 W

WELL NO. # 1 Gray FARM

COMPANY Duke & Wood

CONTRACTOR Duke & Wood

330 Ft. from N. Line
 _____ Ft. from S. Line
 _____ Ft. from E. Line
 330 Ft. from W. Line

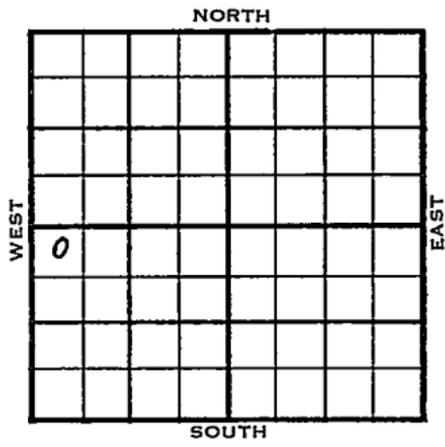

NW NW SW

	ELEVATION	REPORT
1954	1694'	
3/24	Spud 3-18-54 8" @ 235'	Anhy 617 Grandhaven 2192 Drlg. 2202'
3/31	Tarkio 2250 DST 2709-57, 1 hr; 1980' SW 920# Heeb 2764' Lans. 2845' DST 2850-70, 1 hr, 100' M, 300' oil 705# Cong. 3146 RTD 3189 5" @ 2965'	
4/7	WOCT	
4/28	Spud 3-18-54 Oil Well TD 3189' 8" @ 235' Anhy 617', Grandhaven 2192', Tarkio 2250' DST 2709-57', opn 1 hr., rec. 1980' sw, 920# Heeb 2764', Lans 2845' DST 2850-70', opn 1 hr., rec. 100' mud, 300' oil, 705# Cong. 3146' TD 3189' 5" @ 2999' CO to 2970', 22/2865-70, 3000A S/124 bo 3 hrs., FU 2200' oil 10 hrs., S/44 bo 1 hr., P/38 boph Comp. 50 bopd	

COMPLETED


County Russell State Kansas

Sec. 28 (Blk. 14) (Sur. 12W) (Twp. 14) (Rge. 12W) Map No.

Operator Duke & Wood

Well No. 1 Farm Gray

Elev. 1694 Location NW NW SW

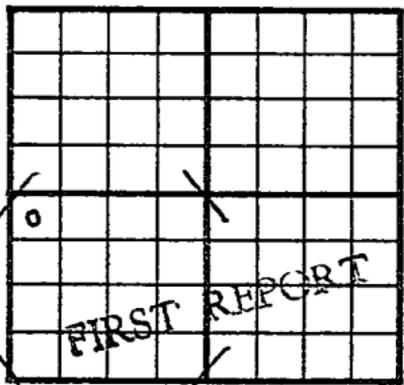

330 Ft. From N Line SW

330 Ft. From W Line Quarter

1st. Report MAR 24 1954

Completion _____

Remarks _____

Duke & Wood - Contr.

Spudding Date 3-18-54

Drig. Data _____

8" @ 235 Anhy 617 Grandhaven 2192

drig. 2202


County Russell State Kansas

Sec. 28 (Blk.) 14 (Sur.) 12W Map No.

Operator Duke & Wood

Well No. 1 Farm Gray

Elev. 1694 Location NW NW SW

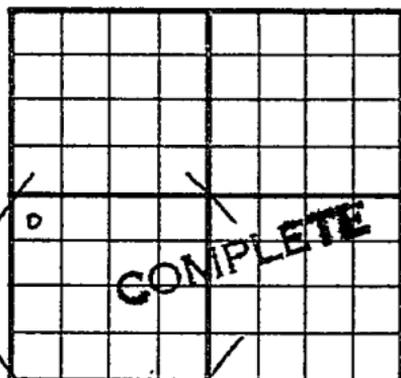

330 Ft. From N Line SW

330 Ft. From W Line Quarter

Ist. Report

Completion APR 28 1954

Remarks

Duke & Wood - Contr.

Spudding Date 3-18-54

Drlg. Data Oil well TD 3189

8" @ 235 Anhy 617 Grandhaven 2192

Tarkio 2250 DST 2709-57 open 1 hr.

Rec. 1980' sw 920# Heeb. 2764

Lans. 2845 DST 2850-70 open 1 hr.

Rec. 100' mud 300' oil 705#

Cong. 3146 TD 3189 5" @ 2999

CO to 2970 22/ 2865-70 3000 A

S/ 124 bo 3 hr. FU 2200' oil 10 hr.

S/ 44 bo 1 hr. P/ 38 boph

Comp. 50 bopd

J. G. McGEHEE

Scout
12-157-7E
Hubert
1/2/54

MAY 3 1954

Scout Cards	_____
Land Small Map	_____
Land Wall Map	_____
Tracings	_____
France Map	_____
Pierce Map	_____
Misc.	_____

Orig. Data