

Sec. 4 Twp. 17 R. 1W

Well No. #1 Christ Ade Farm

W. C. McBride Company

MCP Contractor


 Ft. from N. Line

990' Ft. from S. Line

 Ft. from E. Line

330' Ft. from W. Line

NW SW SE

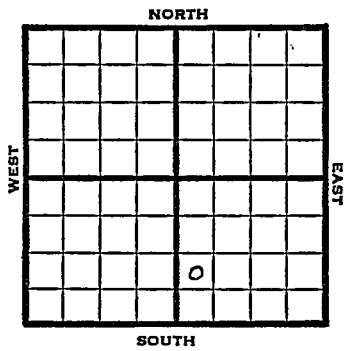

1950 Elev 1288 REPORT

5/17 Spud 5-12-50
10" @ 130'
Drlgl 1850'

5/24 TD 2645
10" @ 130
Lans 2222
Miss 2613
DST 2610-33
open 30 min, rec mud
DST 2628-45
D&A

ABANDONED

McPherson

Form 26 200 Bks. 11-49 Petrol

Kansas

Map No. _____ Sec. 4 Twp. 17 R. 1W

Well No. 1 Christ Ade

W. C. McBride Company

Contractor

N^W SW SE

SECTION PLAT

_____ Ft. from N. Line

900 Ft. from S. Line

_____ Ft. from E. Line

330 Ft. from W. Line



M C P

Location _____

Rig up _____

Drilling and Remarks:

5-12-50

10" @ 130

Drlg. 1850

RECORD

Cased _____ in., _____ ft.

Sand _____

Gas _____

Oil _____

Total Depth _____

PRODUCTION

1st 24 hrs. Nat. _____

1st 24 hrs. after shot _____

Gas _____ Cu. Ft.

Dry Hole _____

Abandoned _____

Date

MAY 17 1950

J. E. TYRA Scout

Kansas


Map No. _____ Sec. 4 Twp. 17 R. 1WWell No. 1 Christ Ade

W. C. McBride _____ Company

N^W SW SE

E 1. 1288 Contractor

SECTION PLAT

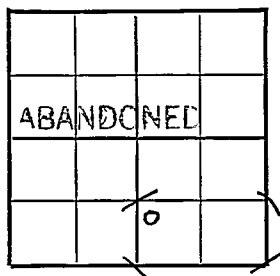

_____ Ft. from N. Line

990 Ft. from S. Line

_____ Ft. from E. Line

330 Ft. from W. LineMcPherson

Location _____

Rig up _____

Drilling and Remarks:

10" C 130
Lans. 2222~~DST 2028~~Miss 2613DST 2610-33Open 30 minRec. mudD.S.T. 2628-45

RECORD

Cased _____ in., _____ ft.

Sand _____

Gas _____

Oil _____

Total Depth 2645

PRODUCTION

1st 24 hrs. Nat. _____

1st 24 hrs. after shot _____

Gas _____ Cu. Ft.

Dry Hole _____

Abandoned _____

D+A
DateMAY 24 1950 19J. E. TYRA Scout