


Section 4 Township 17 Range 1-W

Well No. 4 Henne

Company Williams & Morine

Crowther Pool

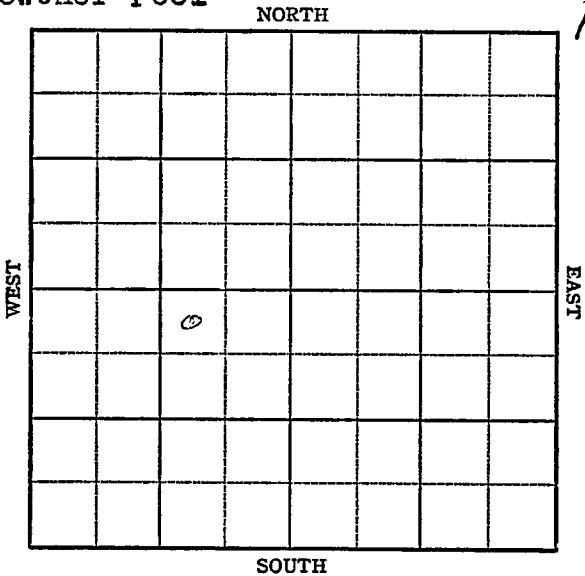

KANSAS McPherson

Sec. 4 Twp. 17 R. 1-W ✓

Well No. 4 Henne Farm

Williams & Morine Company

Crowther Pool


NORTH

330 Ft. from N. Line

_____ Ft. from S. Line

990 Ft. from E. Line

_____ Ft. from W. Line

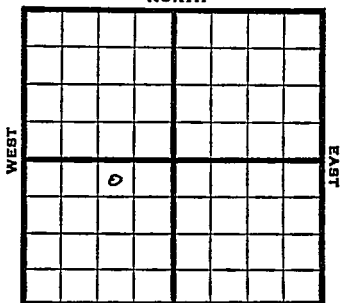

NW NE SW

SOUTH

1947

REPORT

8/27

8" @ 140
 KC 2015' -
 Chat 2606'
 5" @ 2605'
 TD 2618
 1000 acid
 swab 20' oil & 5 wtr per hr
 for three hrs. Pot. 25 bbl.
 Total Depth 2618'

FIRST REPORT

~~8~~
COMPLETED

