


Section 5 Township 17 Range 1 W

Well No. #1 Buckey

Company Bennett & Gould

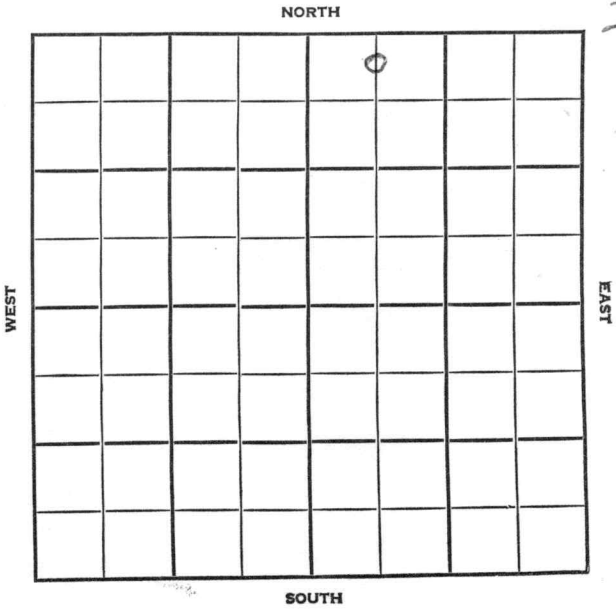

SEC. 5	TWP. 17	R. 1W
-----------	------------	----------

WELL NO. #1 Buckey FARM

COMPANY Bennett & Gould

CONTRACTOR Mallard

Gypsum Creek


_____ Ft. from N. Line

_____ Ft. from S. Line

_____ Ft. from E. Line

_____ Ft. from W. Line

C N $\frac{1}{2}$ NW NE

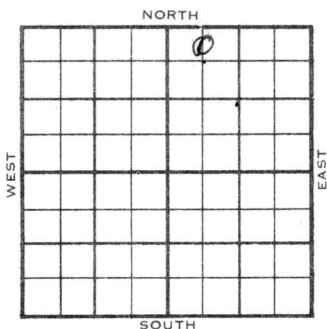

1956	ELEVATION	REPORT
------	-----------	--------

2-8	Comm. 2-3-56 8" @ 137/90 Drlg. 1650
-----	-------------------------------------------

County McPherson Elev. 1332
 Sec. 5 Twp. 17 Rge. 1W
 Company Bennett & Gould
 Farm Name Buckey No. 1

TOPS	DEPTH	LOG	DATUM
Anh.			
TP.			
H.			
Tr.			
Dg.			
Bl.			
L.			
K.C.			
B.K.C.			
Ce.			
C.			
M.			
K.			
Mz.			
Me.			
V.			
S.			
S.			
A.			
R.			
PE.			
G.			
T.D.			

Loc. in Sec. C N¹/₂ NW NE
 Geol. _____
 Contr. Mallard
 Pool Gypsum Creek

		0
FIRST REPORT		
FEB 8 '56		

Date Comm. 2-3-56
8" @ 137/90 drlg. 1650

[Large handwritten scribble]

Co.

Lse.

No.

Sec.

T.

R.

