



Sec. 30 Twp. 14 R. 12-W

Well No. #1 Heard Farm

Gulf Company

(Semi-Wildcat)


\_\_\_\_\_ Ft. from N. Line

990 Ft. from S. Line

\_\_\_\_\_ Ft. from E. Line

330 Ft. from W. Line

Elev. 1704

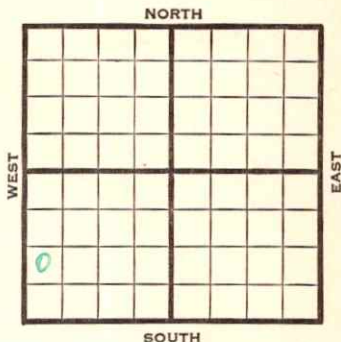

1942	REPORT
5/13	Derrick.
5/20	8" - 416' WOC.
5/27	Drlg. 2495'
6/3	Cong. 3129' Arb. 3137'
	5" - 3137½' T.D. 3141'
	RUST. S.O.
6/10	2850' oil 6 hours. Swab 43 oil in 1 hour. SD for tanks.
6/17	Pump 73 oil in 4 hours.
6/24	Arb. 3137'
	5" - 3137½'
	T.D. 3141'
	Echometer potential 1123 bbls. plus 72 water. 40.5 Gravity
	<del>COMPLETED</del> COMPLETED

Russell

Map No. 56 Sec. 30 Twp. 14 R. 12WWell No. 1 Heard

Gulf

Company

FIRST REPORT

Contractor

NW SW SW

## SECTION PLAT

o			

\_\_\_\_\_ Ft. from N. Line

990 Ft. from S. Line

\_\_\_\_\_ Ft. from E. Line

330 Ft. from W. Line

SEMI WILDCAT

## RECORD

Location \_\_\_\_\_

Cased \_\_\_\_\_ in., \_\_\_\_\_ ft.

Rig up \_\_\_\_\_

Sand \_\_\_\_\_

Drilling and Remarks:

Gas \_\_\_\_\_

Oil \_\_\_\_\_

Total Depth \_\_\_\_\_

Derrick

## PRODUCTION

1st 24 hrs. Nat. \_\_\_\_\_

1st 24 hrs. after shot \_\_\_\_\_

Gas \_\_\_\_\_ Cu. Ft.

Dry Hole \_\_\_\_\_

Abandoned \_\_\_\_\_

Date

MAY 13 1942

19

S. J. LEWIS

Scout

