


KANSAS

Section 32 Township 14 Range 12-W

Well No. #4 Kaps

Company Jones & Shelborne
Hall-Gurney

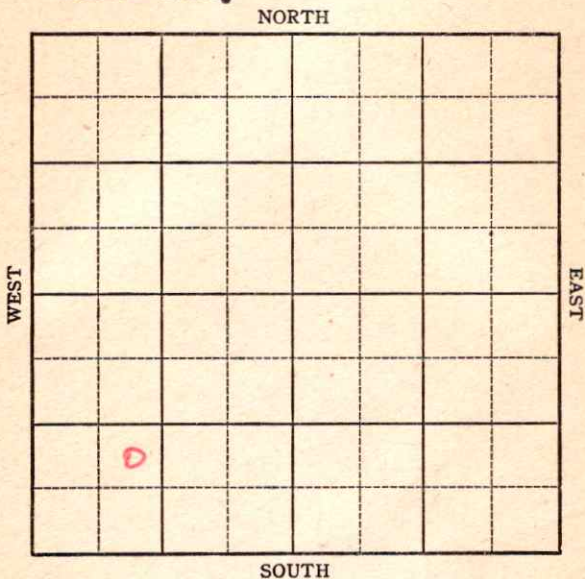

KANSAS

Russell

Sec. 32 Twp. 14 R. 12-W ✓

Well No. #4 Kaps Farm
Jones & Shelborne Company
Hall-Gurney


 Ft. from N. Line

990 Ft. from S. Line

 Ft. from E. Line

990 Ft. from W. Line

NE SW SW

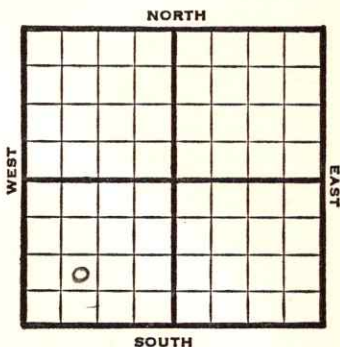

1947	Elev 1761'	REPORT
6/11	Location	
6/17	"	
6/24	"	
7/1	Rigging up cable	
7/8	15" @ 385' Drlg 405'	
7-16	1190 Drlg.	
7/22	13" @ 699' Drlg 1899'	
7/29	SSO 2260-65' TD 2505' Run 8"	
8/6	Lansing 2928' 7" @ 255' TD 2975'	
8/13	Pump 23 oil PH, 5 hrs.	
8/20	Lans 2928' 7" @ 2955' Acid 5000 Pump 203 Pot. Gr. 40.9 T.D. 2975 (Comp)	COMPLETED

Map No. _____ Sec. 32 Twp. 14 R. 12W

Well No. 4 Kaps

Jones & Shelborne Company

FIRST REPORT

Contractor

NE SW SW


SECTION PLAT

_____ Ft. from N. Line

990 Ft. from S. Line

_____ Ft. from E. Line

990 Ft. from W. Line

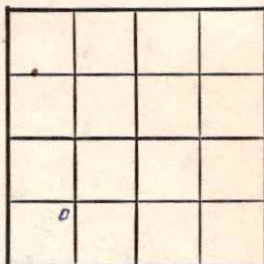

Russell County

Location X

Rig up _____

Drilling and Remarks:

RECORD

Cased _____ in., _____ ft.

Sand _____

Gas _____

Oil _____

Total Depth _____

PRODUCTION

1st 24 hrs. Nat. _____

1st 24 hrs. after shot _____

Gas _____ Cu. Ft.

Dry Hole _____

Abandoned _____

Date

JUN 1 1 1947 19 S. J. LEWIS Scout

Map No. 56 Sec. 32 Twp. 14 R. 12W

Well No. 4 Kaps

Jones & Shelborne Company

COMPLETE

Contractor

NE SW SW

E11761
SECTION PLAT

 Ft. from N. Line

990 Ft. from S. Line

 Ft. from E. Line

990 Ft. from W. Line

0			

Russell County

Location

Rig up

Drilling and Remarks:

Liams 2925
2" @ 280-5
5000 rods
Run 203 ft
402 ft

RECORD

Cased in., ft.

Sand

Gas

Oil

Total Depth 2925

PRODUCTION

1st 24 hrs. Nat.

1st 24 hrs. after shot

Gas Cu. Ft.

Dry Hole

Abandoned

Date

AUG 20 1947

19

S. J. LEWIS

Scout