


Section 30 Township 14 Range 12WWell No. 1 HeardCompany Fred Haynes

Hall-Gurney

NORTH

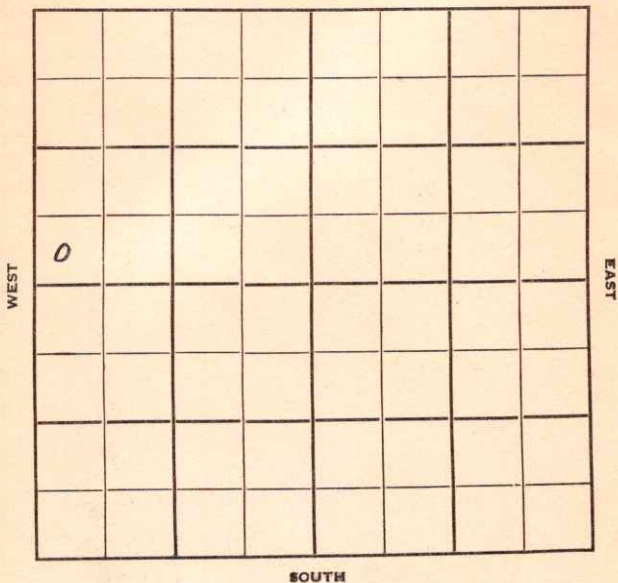

O. W. D. D.

Russell

KANSAS

Sec. 30 Twp. 14 R. 12W

Well No. #1 Heard Farm

Fred Haynes

Company

Hall-Gurney Pool (Haynes, Cont.) NORTH

 Ft. from N. Line

330'


 Ft. from S. Line

 Ft. from E. Line

330'

 Ft. from W. Line

WEST

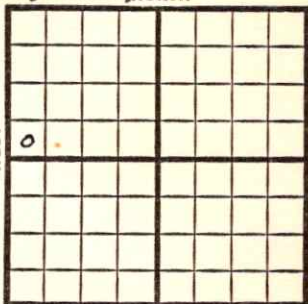

SOUTH

SW NW

1949 Elev. 1706' REPORT

7/6	Rig
7/12	Drlg 280'
7/20	15"@ 65'
	13 "@ 360'
	10"@ 675'
	Drlg 1340'
7/27	8"@ 1755'
	Drlg 1785'
8/3	Drlg 2090'
8/10	SSO 2215'-22'
	8"@ 2239'
	SO 2275'
	UR 8"
8/17	8"@ 2272'
	TD 2275'
	Swb & flow 10 bbls oil PH
8/24	"
8/31	"
9/7	Tarkio 2215'
	8" @ 2212'
	Pump 20 oil & 8 W Pot.
	Grav. 40.7
	TD 2275'

COMPLETED

OVER

O. W. D. D

O. W. D. D

1950

1/11

TD 2943'

8"@ 2272'

5"@ 2854'

Plug back to 2230'

Perf 12/2211-22

PP 25 BOPD

Comp

COMPLETED

Map No. _____ Sec. 30 Twp. 14 R. 12WWell No. 1 HeardFred Haynes

Company

Haynes

Contractor


SW NW

FIRST REPORT
SECTION PLAT

_____ Ft. from N. Line

330 Ft. from S. Line

_____ Ft. from E. Line

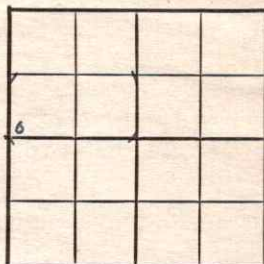330 Ft. from W. LineRussell County

Location _____

Rig up _____

Drilling and Remarks:

Rig

RECORD

Cased _____ in., _____ ft.

Sand _____

Gas _____

Oil _____

Total Depth _____

PRODUCTION

1st 24 hrs. Nat. _____

1st 24 hrs. after shot _____

Gas _____ Cu. Ft.

Dry Hole _____

Abandoned _____

Date

JUL 6 1949 19S. J. LEWIS Scout

Kansas

Map No. 556 Sec. 30 Twp. 14 R. 12WWell No. 1 Heard

Fred Haynes Company

COMPLETE

Contractor

E. 1706

SW NW

SECTION PLAT

 Ft. from N. Line330 Ft. from S. Line Ft. from E. Line330 Ft. from W. Line

Russell County

Location Rig up

Drilling and Remarks:

Marker 22155' @ 2212Prod 20 oil + 8W Bkt40 2 8 11

RECORD

Cased in., ft.Sand Gas Oil Total Depth 2275

PRODUCTION

1st 24 hrs. Nat. 1st 24 hrs. after shot Gas Cu. Ft.Dry Hole Abandoned

Date

SEP 7 1949 19S. J. LEWIS Scout

Kansas

Map No. _____ Sec. 30 Twp. 14 R. 12WWell No. 1 HeardFred Haynes Company

Contractor

SW NW

SECTION PLAT

COMPLETE			
o			

Ft. from N. Line

330 Ft. from S. Line

Ft. from E. Line

330 Ft. from W. Line

Russell County

Location _____

Rig up _____

Drilling and Remarks:

5" @ 2272

5" @ 2854

Plug Back To

2230

perf 12/2211-22

PP 25 BOPD

RECORD

Cased _____ in., _____ ft.

Sand _____

Gas _____

Oil _____

Total Depth 2943

PRODUCTION

1st 24 hrs. Nat. _____

1st 24 hrs. after shot _____

Gas _____ Cu. Ft.

Dry Hole _____

Abandoned _____

Date

JAN 11 1950 19

J. E. TYRA

Scout