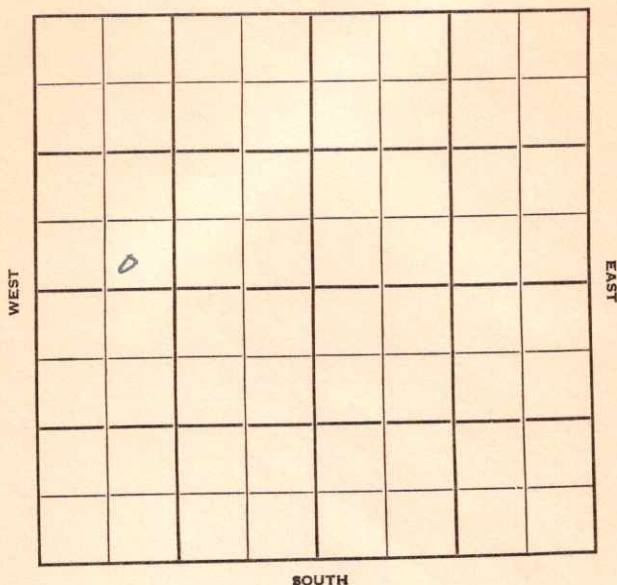


KANSAS

Russell

Section 30 Township 14 Range 12WWell No. 2 HeardCompany Fred HaynesHall-Gurney
NORTH

Russell KANSAS ✓

Sec. 30 Twp. 14 R. 12W

Well No. #2 Heard Farm

Fred Haynes

Company

Hall-Gurney Pool (Fred Haynes, Cont.)

NORTH

Ft. from N. Line


330'

Ft. from S. Line

Ft. from E. Line

990'

Ft. from W. Line

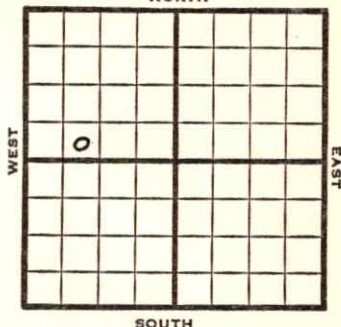

SE SW NW

SOUTH

1949 Elev 1703' REPORT

8/31 Anhy 645'
10" @ 654'
Drlg. 690'
9/7 Drlg. 1655'
9/14 8" @ 2200'
Drlg 2208'
9/21 Drlg. 2710'
9/28 Lansing 2840'
TD 2885'
5" @ 2865'
10/5 1000 acid
Drlg 3050'
10/12 5" @ 3082'
Cong 3130'
TD 3167' in Cong.
10/19 TD 3167'
Lans 2840'
Cong 3130'
5 @ 3082'
Pulled 5"
7" @ 2860'
1000 acid
Pump 80 Oil Pot
39° Gr.
Comp

COMPLETED

Map No. _____ Sec. 30 Twp. 14 R. 12WWell No. 2 HeardFred Haynes

Company

Fred Haynes

Contractor

SE SW NW

FIRST REPORT
SECTION PLAT

o			

 Ft. from N. Line330 Ft. from S. Line Ft. from E. Line990 Ft. from W. LineRussell County

Location _____

Rig up _____

Drilling and Remarks:

Anhy 645

10" @ 654

drlg. 690

RECORD

Cased _____ in., _____ ft.

Sand _____

Gas _____

Oil _____

Total Depth _____

PRODUCTION

1st 24 hrs. Nat. _____

1st 24 hrs. after shot _____

Gas _____ Cu. Ft.

Dry Hole _____

Abandoned _____

Date

AUG 31 1949 19S. J. LEWIS

Scout

Kansas


Map No. _____ Sec. 30 Twp. 14 R. 12WWell No. 2 Heard

Fred Haynes _____ Company

COMPLETE

Contractor

SE SW NW

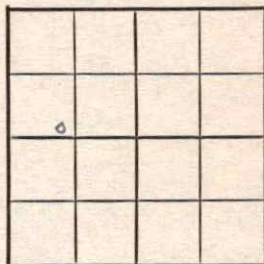E 1/208
SECTION PLAT

_____ Ft. from N. Line

330 Ft. from S. Line

_____ Ft. from E. Line

990 Ft. from W. Line

Russell County

RECORD

Location _____

Cased _____ in., _____ ft.

Rig up _____

Sand _____

Drilling and Remarks:

Gas _____

Oil _____

Total Depth 3167

PRODUCTION

1st 24 hrs. Nat. _____

1st 24 hrs. after shot _____

Gas _____ Cu. Ft.

Dry Hole _____

Abandoned _____

Date

OCT 19 1949 19

S. J. LEWIS Scout