

KANSAS

Russell


Section 32 Township 14 Range 12W

Well No. 5 Steinle "B"

Company Cities Service

Hall-Gurney

NORTH

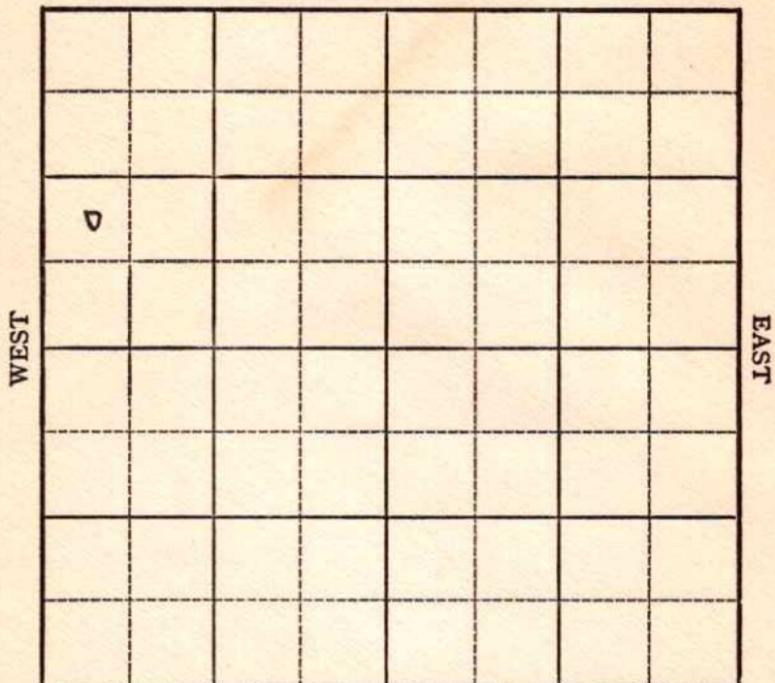

WEST

EAST

SOUTH

KANSAS

Russell

Sec. 32 Twp. 14 R. 12W ✓

Well No. #5 Steinle "B" Farm _____

Cities Service

Company

Hall-Gurney Pool

_____ Ft. from N. Line


990'

_____ Ft. from S. Line

_____ Ft. from E. Line

330' _____ Ft. from W. Line

NW SW NW

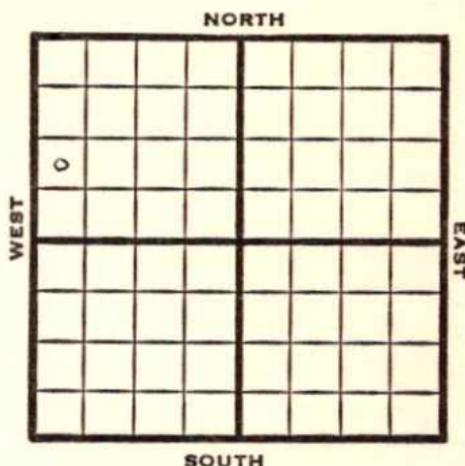

1949

Elev 1721'

R E P O R T

2/23
3/2

Location
8" @ 398'

Drlg 1880'

3/8

Drlg 3178'

3/16

Lansing 2880'

Arb. 3185'

T^D 3187'

5 @ 3186'

3/23

TD 3192'

Lans. 2880'

Arb. 3185'

5" @ 3186'

PB 3038'

43 shots 2907'-25

2000 acid

Pump 202 Oil / 35 Rot

40⁹ Grl

Comp

COMPLETED

Kansas

Map No. _____ Sec. 32 Twp. 14 R. 12^WWell No. 5 Steinle "B"Cities Service CompanyFIRST REPORT Contractor

NW SW NW

SECTION PLAT

_____ Ft. from N. Line

990 Ft. from S. Line

_____ Ft. from E. Line

330 Ft. from W. Line

Russell County

0			

Location X

Rig up _____

Drilling and Remarks:

RECORD

Cased _____ in., _____ ft.

Sand _____

Gas _____

Oil _____

Total Depth _____

PRODUCTION

1st 24 hrs. Nat. _____

1st 24 hrs. after shot _____

Gas _____ Cu. Ft.

Dry Hole _____

Abandoned _____

Date

FEB 23 1949 19 _____S. J. LEWIS Scout

Kansas

Map No. 56 Sec. 32 Twp. 14 R. 12WWell No. 5 Steinle "B"Cities Service CompanyCOMPLETE Contractor

NW SW NW

E. 1724
SECTION PLAT

0			

Ft. from N. Line

990 Ft. from S. Line

Ft. from E. Line

330 Ft. from W. Line

Russell County

RECORD

Location _____

Cased _____ in., _____ ft.

Rig up _____

Sand _____

Drilling and Remarks:

Gas _____

Oil _____

Total Depth 2192

PRODUCTION

1st 24 hrs. Nat. _____

1st 24 hrs. after shot _____

Gas _____ Cu. Ft.

Dry Hole _____

Abandoned _____

Date

MAR 23 1949 19

S. J. LEWIS

Scout

Log 2880
 C. 18/185.
 5" C. 186.
 P. 183088
 432 ho to 907-25
 2000 ac. oil
 Prof. 202 oil 73588
 459 3/4