

KANSAS

Russell

Section 32 Township 14 Range 12WWell No. 5 KapsCompany Julian Oil Royalty

Hall-Gurney

NORTH

WEST

EAST

	o						

SOUTH

KANSAS

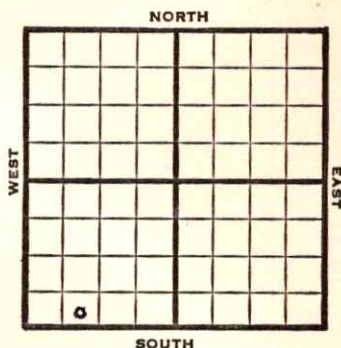
Sec. 32 Twp. 14 R. 12WWell No. #5 Kaps Farm
Julian Oil Royalty Company

Hall-Gurney

Ft. from N. Line

330 Ft. from S. Line

Ft. from E. Line

990 Ft. from W. Line
SE SW SW1947 **Elev. 1787'** REPORT

11/5	Drlg. 415
11/12	Drlg. 1650'
11/19	15" @ 400' 12" @ 720' 10" @ 1995' Drlg. 2150'
11/25	8" @ 2565' Drlg. 2580'
12/3	Drlg. 3055'
12/10	Lansing 2970' Arbuckle 3227' @ 30' TD 7" @ 3227' RUST
12/30	Arb. 3227' 7" @ 3227' Pump 324 Pot 40.9 Gr. TD 3230'

COMPLETED

Map No. _____ Sec. 32 Twp. 14 R. 12W

Well No. 5 Kaps

Julian Oil Royalty Company

FIRST REPORT

Contractor

SE SW SW

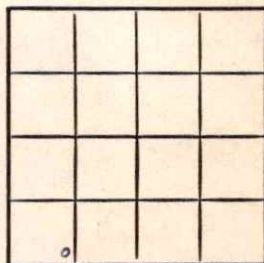
SECTION PLAT

_____ Ft. from N. Line

330 Ft. from S. Line

_____ Ft. from E. Line

990 Ft. from W. Line



Russell County

Location _____

Rig up _____

Drilling and Remarks:

drlg. 415

RECORD

Cased _____ in., _____ ft.

Sand _____

Gas _____

Oil _____

Total Depth _____

PRODUCTION

1st 24 hrs. Nat. _____

1st 24 hrs. after shot _____

Gas _____ Cu. Ft.

Dry Hole _____

Abandoned _____

Date

NOV 5 1947

19

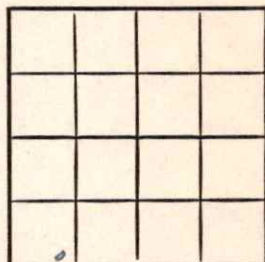
S. J. LEWIS

Scout

Kansas

Map No. 56 Sec. 32 Twp. 14 R. 12WWell No. 5 KapsJulian Oil Royalty CompanyCOMPLETE Contractor

SE SW SW

E 1, 1787
SECTION PLAT Ft. from N. Line330 Ft. from S. Line Ft. from E. Line990 Ft. from W. LineRussell CountyLocation Rig up

Drilling and Remarks:

CR 32277" @ 3227Pump 32440 1/2

RECORD

Cased in., ft.Sand Gas Oil Total Depth 3220

PRODUCTION

1st 24 hrs. Nat. 1st 24 hrs. after shot Gas Cu. Ft.Dry Hole Abandoned

Date

DEC 30 1947 19S. J. LEWIS Scout