


Section 32 Township 14 Range 12W

Well No. #7 Kaps

Company Jones, Shelburne

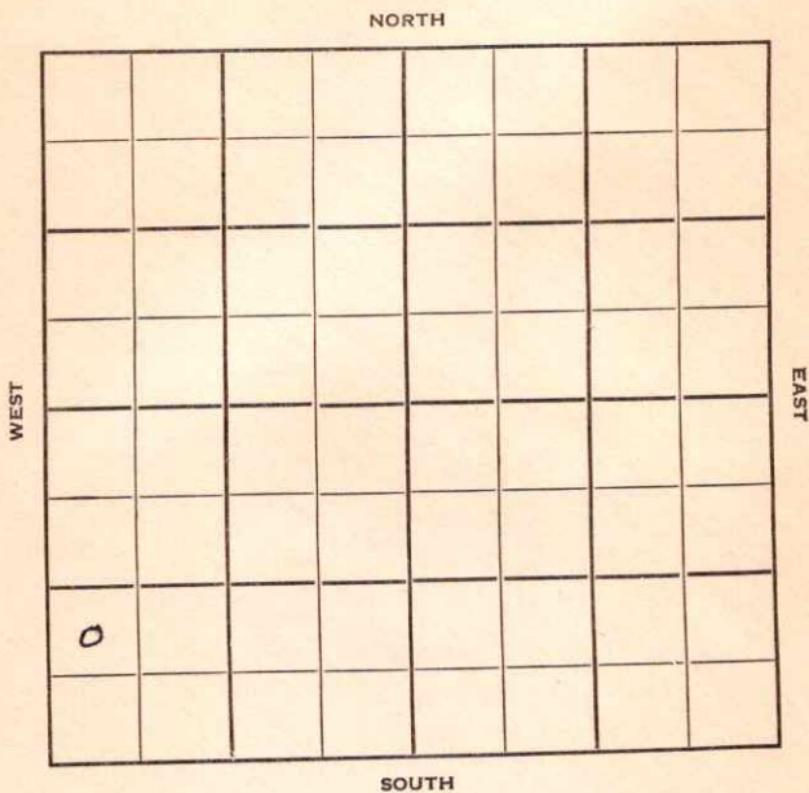

Russell

KANSAS

Sec. 32 Twp. 14 R. 12W

Well No. #7 Kaps Farm

Jones, Shelburne Company

Jones, Shelburne Contractor

Hall Gurney


_____ Ft. from N. Line

990 Ft. from S. Line

_____ Ft. from E. Line

330 Ft. from W. Line

NW SW SW

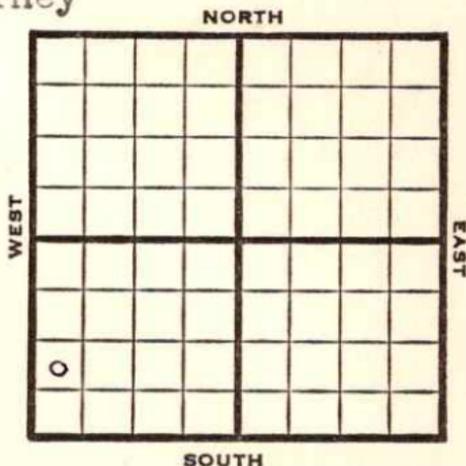

1952

Elev. 1758

REPORT

- 2/13 Spud 2-12-52
- 2/20 20" @ 21 15" @ 351'
Anhy 691' 10" @ 693'
Drlg. 698'
- 3/5 8" @ 1995'
Drlg. 2215'
- 3/12 Drlg. 2410'
- 3/19 7" @ 2600 Drlg. 2685'
- 3/25 Drlg. 2946'
- 4/1 **Dodge 2847** **Lans. 2907**
- 4/9 7" @ 3019'
Drlg. 3180'
- 4/23 TD 3219' Shut down
- 4/30 **Arb. 3217 SO** B/27 gal wtr & 13 gal
OPH for 17 hrs. 5" @ 3218
PB 3191 20/2990-95 B/12 gal w &
8 gal OPH for 24 hrs. 3000A
Est. 3 BO & 10 BWPH
- 5/7 NR
- 5/14 NR
- 5/21 "
- 5/28 "

OVER

1952

6/4 Comm. 2-12-52
Oil Well TD 3219
20" @ 21 15" @ 351
Anhy 691 10" @ 693
8" @ 1995 7" @ 2600
Dodge 2847 Lans. 2907
Arb. 3217 TD 3219
B/27 gw 13 boph 5" @ 3218
PB 3191 20/2990-95 B/12 gw
8 goph 3000 A 3bo 10 bwph
Comp. 22 bopd 53 bw

COMPLETED

