

KANSAS

Russell

Section 32 Township 14 Range 12W


Well No. #2 Kaps

Company Cities Service
Hall-Gurney Pool

NORTH

WEST

EAST

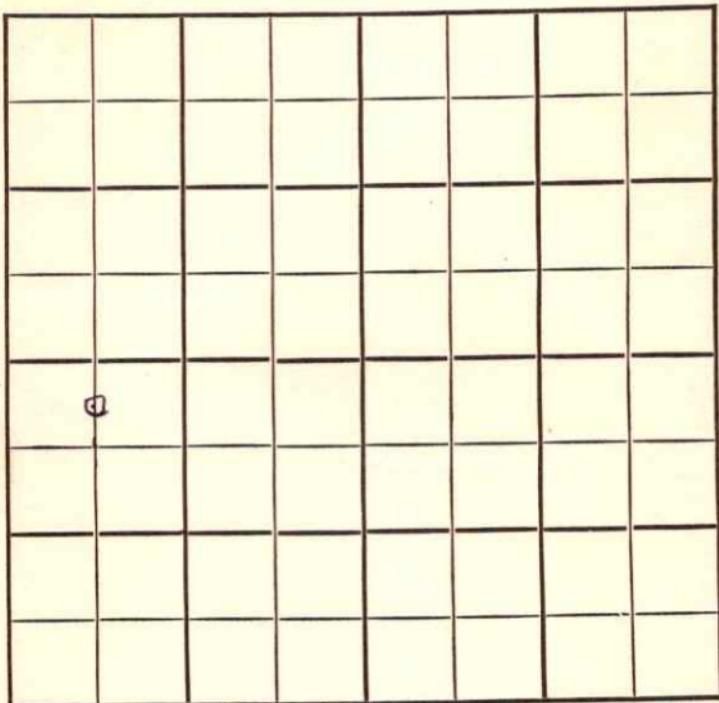

SOUTH

KANSAS

Russell County ✓

Sec. 32 Twp. 14 R. 12W

Well No. #2 Kaps Farm _____


Cities Service Company _____
Hall-Gurney Pool

330' Ft. from N. Line

_____ Ft. from S. Line

_____ Ft. from E. Line

660' Ft. from W. Line

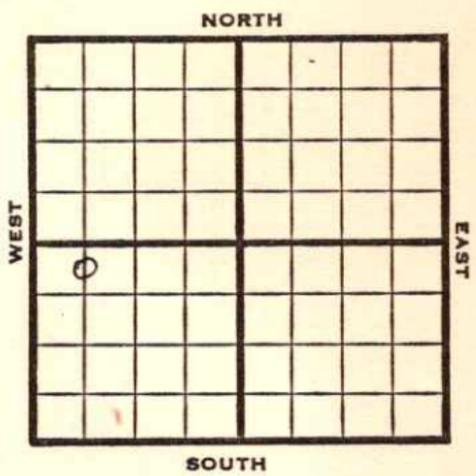

C N L NW SW

1948 **Elev. 1733'** **REPORT**

4/21 Drlg. 403'

4/28 Drlg. 2705'

5/5 8" @ 412'
Lansing 2894'
Arbuckle 3180-83'
TD 3183'
5" @ 3181'
RUST

5/12 "

5/19 "

5/26 **Arbuckle 3175'**
5" @ 3176'
Pump 142 oil Pot.
Gr. 40.9
TD 3178'

COMPLETED

Map No. _____ Sec. 32 Twp. 14 R. 12W

Well No. 2 Kaps

_____ Cities Service _____ Company

FIRST REPORT

_____ Contractor

C N L NW SW

SECTION PLAT

330 Ft. from N. Line

_____ Ft. from S. Line

_____ Ft. from E. Line

660 Ft. from W. Line

Russell County

Location _____

Rig up _____

Drilling and Remarks:

drlg. 403

RECORD

Cased _____ in., _____ ft.

Sand _____

Gas _____

Oil _____

Total Depth _____

PRODUCTION

1st 24 hrs. Nat. _____

1st 24 hrs. after shot _____

Gas _____ Cu. Ft.

Dry Hole _____

Abandoned _____

Date

APR 21 1948

19

S. J. LEWIS

Scout

Map No. 56 Sec. 32 Twp. 14 R. 12W

Well No. 2 Kaps

Cities Service Company

COMPLETE

Contractor

C N L NW SW

E 11733
SECTION PLAT

330 Ft. from N. Line

_____ Ft. from S. Line

_____ Ft. from E. Line

660 Ft. from W. Line

•			

Russell County

Location _____

Rig up _____

Drilling and Remarks:

3125
5" @ 3126

Pump 142 oil OK

40 2 1/2

RECORD

Cased _____ in., _____ ft.

Sand _____

Gas _____

Oil

Total Depth 3125

PRODUCTION

1st 24 hrs. Nat. _____

1st 24 hrs. after shot _____

Gas _____ Cu. Ft.

Dry Hole _____

Abandoned _____

Date

MAY 26 1948 19

S. J. LEWIS Scout