


Section 32 Township 14 Range 12W

Well No. 3 Steinle "B"

Company Cities Service

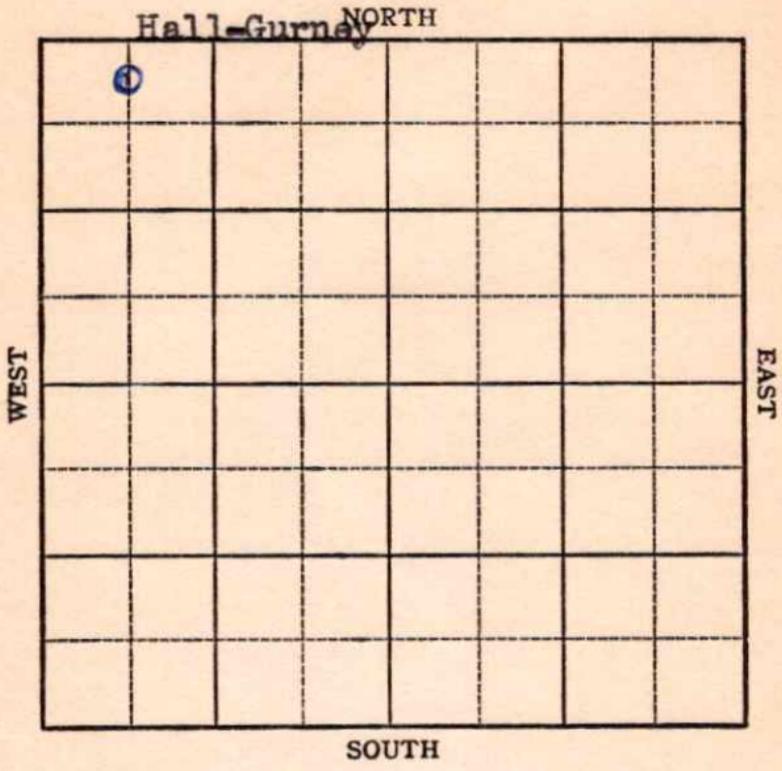

**KANSAS**

Russell

Sec. 3 2

Twp. 14

R. 12W

Well No. #3 Steinle "B" Farm \_\_\_\_\_

\_\_\_\_\_ Cities Service \_\_\_\_\_ Company


330 Hall-Gurney  
Ft. from N. Line

\_\_\_\_\_ Ft. from S. Line

\_\_\_\_\_ Ft. from E. Line

660 \_\_\_\_\_  
Ft. from W. Line

C N L NW NW

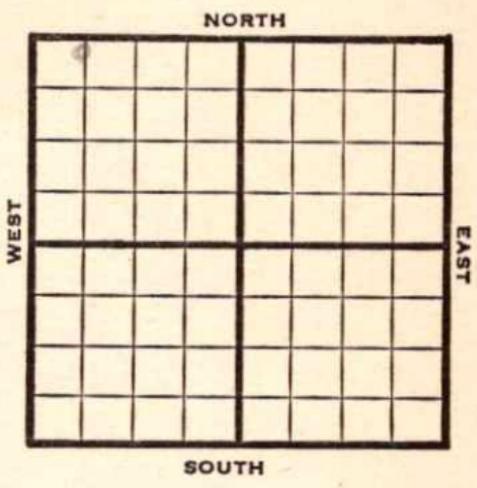

1947 **Elev. 3164** REPORT

- 9/10 Loc.
- 9/17 RUR
- 9/24 8" @ 400'  
Drlg. 2650'
- 10/1 **Gorham 3160'**  
TD 3164'  
5" @ 3161'  
RUST
- 10/8 **Gorham 3160**  
5" @ 3161'  
Echo Pot 2565' oil  
/ 20% W Pot  
TD 3164  
Gravity 40

**COMPLETED**

Kansas

Map No. \_\_\_\_\_ Sec. 32 Twp. 14 R. 12WWell No. 3 Steinle "B"

Cities Service \_\_\_\_\_ Company

FIRST REPORT

Contractor \_\_\_\_\_

C N L NW NW

## SECTION PLAT

330 Ft. from N. Line

\_\_\_\_\_ Ft. from S. Line

\_\_\_\_\_ Ft. from E. Line

660 Ft. from W. Line

<u>D</u>			

Russell County

Location X

Rig up \_\_\_\_\_

Drilling and Remarks:

## RECORD

Cased \_\_\_\_\_ in., \_\_\_\_\_ ft.

Sand \_\_\_\_\_

Gas \_\_\_\_\_

Oil \_\_\_\_\_

Total Depth \_\_\_\_\_

## PRODUCTION

1st 24 hrs. Nat. \_\_\_\_\_

1st 24 hrs. after shot \_\_\_\_\_

Gas \_\_\_\_\_ Cu. Ft.

Dry Hole \_\_\_\_\_

Abandoned \_\_\_\_\_

Date

SEP 10 1947 19S. J. LEWIS Scout

Map No. 576 Sec. 32 Twp. 14 R. 12W

Well No. 3 Steinle "B"

Cities Service Company

COMPLETE Contractor

C N L NW NW

E 11718  
SECTION PLAT

330 Ft. from N. Line

\_\_\_\_\_ Ft. from S. Line

\_\_\_\_\_ Ft. from E. Line

660 Ft. from W. Line

0			

Russell County

Location \_\_\_\_\_

Rig up \_\_\_\_\_

Drilling and Remarks:

*Graham 3160*  
*5" @ 3161*  
*Echo 2585 oil*  
*+ 20% W Pot*  
*40° SW*

RECORD

Cased \_\_\_\_\_ in., \_\_\_\_\_ ft.

Sand \_\_\_\_\_

Gas \_\_\_\_\_

Oil \_\_\_\_\_

Total Depth 3164

PRODUCTION

1st 24 hrs. Nat. \_\_\_\_\_

1st 24 hrs. after shot \_\_\_\_\_

Gas \_\_\_\_\_ Cu. Ft.

Dry Hole \_\_\_\_\_

Abandoned \_\_\_\_\_

Date

OCT 8 1947 19

S. J. LEWIS

Scout